

CARD MUST BE TYPED

State of Kansas  
**NOTICE OF INTENTION TO DRILL**  
(see rules on reverse side)

**CANCELLED**

CARD MUST BE SIGNED

Starting Date: ..2.....16.....85.....  
month day year

API Number 15- 163-22,619-06-00 <sup>4-25-85</sup>

OPERATOR: License # 5407

~~NE~~-NW-SW.. Sec 24.. Twp 7... S, Rge 18...  East  West  
(location)

Name ..... Hupfer Oil & Gas .....

Address ..... 3711 Country Lane .....

City/State/Zip ..... Hays, KS 67601 .....

Contact Person ..... Dennis D. Hupfer .....

Phone ..... 913-628-8666 .....

..... 2310 ..... Ft North from Southeast Corner of Section  
..... 4290 ..... Ft West from Southeast Corner of Section  
(Note: Locate well on Section Plat on reverse side)

CONTRACTOR: License # 5107

Nearest lease or unit boundary line ..... 330 ..... feet.

Name ..... H-30, Inc. ....

County ..... Rooks .....

City/State ..... Wichita, KS 67202 .....

Lease Name ..... Kuiken ..... Well# ..... 1 .....

Well Drilled For: Well Class: Type Equipment:

Domestic well within 330 feet :  yes  no

Oil  Swd  Infield  Mud Rotary

Municipal well within one mile :  yes  no

Gas  Inj  Pool Ext.  Air Rotary

Depth to Bottom of fresh water ..... 75 ..... feet

OWWO  Expl  Wilcat  Cable

Lowest usable water formation ..... Dakota .....

If OWWO: old well info as follows:

Depth to Bottom of usable water ..... 700 ..... feet

Operator .....

Surface pipe by Alternate : 1  2

Well Name .....

Surface pipe to be set ..... 1190 ..... feet

Comp Date ..... Old Total Depth .....

Conductor pipe if any required ..... 90 ..... feet

Projected Total Depth ..... 3350 ..... feet

Ground surface elevation ..... 1763 ..... feet MSL

Projected Formation at TD ..... Arbuckle .....

This Authorization Expires ..... 7-17-85 .....

Expected Producing Formations ..... Lansing/Arbuckle .....

Approved By ..... *Dennis D. Hupfer* .....

I certify that we will comply with K.S.A. 55-101, et seq., plus eventually plugging holes to C.C. specifications.


Date 1-16-85 ..... Signature of Operator or Agent *Dennis D. Hupfer* .....

Title President .....

**Must be filed with the K.C.C. five (5) days prior to commencing well  
This card void if drilling not started within six (6) months of date received by K.C.C.**

**Important procedures to follow:**

**A Regular Section of Land  
1 Mile = 5,280 Ft.**

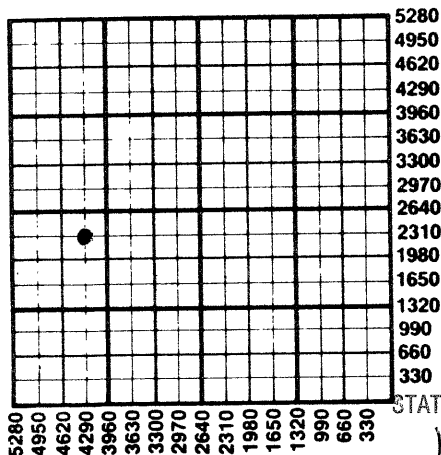

1. Notify District office before setting surface casing.
2. Set surface casing by circulating cement to the top.
3. File completion forms ACO-1 with K.C.C. within 90 days of well completion, following instructions on ACO-1, side 1, and including copies of wireline logs.
4. Notify District office 48 hours prior to old well workover or re-entry.
5. Prior to plugging, prepare a plugging plan, then obtain agreement from the appropriate district office for an approved plugging plan.
6. Submit plugging report (CP-4) to K.C.C. after plugging is completed.
7. Obtain an approved injection docket number before disposing of salt water.
8. Notify K.C.C. within 10 days when injection commences or terminates.
9. If an alternate 2 completion, cement in the production pipe from below any usable water to surface within 120 days of spud date.

RECEIVED

STATE CORPORATION COMMISSION

1-17-85  
JAN 17 1985

**State Corporation Commission of Kansas  
Conservation Division  
200 Colorado Derby Building  
Wichita, Kansas 67202  
(316) 263-3238**

CONSERVATION DIVISION  
Wichita, Kansas