

CARD MUST BE TYPED

State of Kansas
NOTICE OF INTENTION TO DRILL
(see rules on reverse side)

CARD MUST BE SIGNED

Starting Date: August 10 1984
month day year

API Number 15- 163-22, 456-00-00

OPERATOR: License # 8420

NE, NW, NE Sec 24, Twp 7 S, Rge 18
(location) East West

Name S & K Enterprises

Address Box 544

City/State/Zip Hoxie, KS 67740

Contact Person Ken Kaba

Phone 913 675-2396 or 675-2100

4950 Ft North from Southeast Corner of Section

1650 Ft West from Southeast Corner of Section

(Note: Locate well on Section Plat on reverse side)

CONTRACTOR: License # 5381

Nearest lease or unit boundary line 330 feet.

County Rooks

Name Big Springs Drilling

Lease Name City of Stockton Drig. Unit I-4

City/State Wichita KS

Well#

Domestic well within 330 feet: yes no

Municipal well within one mile: yes no

Well Drilled For: Well Class: Type Equipment:

- Oil Swd Infield Mud Rotary
- Gas Inj Pool Ext. Air Rotary
- OWWO Expl Wildcat Cable

Depth to Bottom of fresh water feet

Lowest usable water formation *Dakota* feet

Depth to Bottom of usable water *750* feet

Surface pipe by Alternate: 1 2

Surface pipe to be set *1250* feet

Conductor pipe if any required *90* feet

Ground surface elevation *1781* feet MSL

This Authorization Expires *2-6-85*

Approved By *8-6-84* *R*

If OWWO: old well info as follows:

Operator

Well Name

Comp Date Old Total Depth

Projected Total Depth *3350* feet

Projected Formation at TD *Arbuckle*

Expected Producing Formations *Arbuckle*

I certify that we will comply with K.S.A. 55-101, et seq., plus eventually plugging hole to K.C.C. specifications.


Date *8/3/84* Signature of Operator or Agent

Title *Agent*
mhc/kone 8/6/84

**Must be filed with the K.C.C. five (5) days prior to commencing well
This card void if drilling not started within six (6) months of date received by K.C.C.**

Important procedures to follow :

**A Regular Section of Land
1 Mile = 5,280 Ft.**

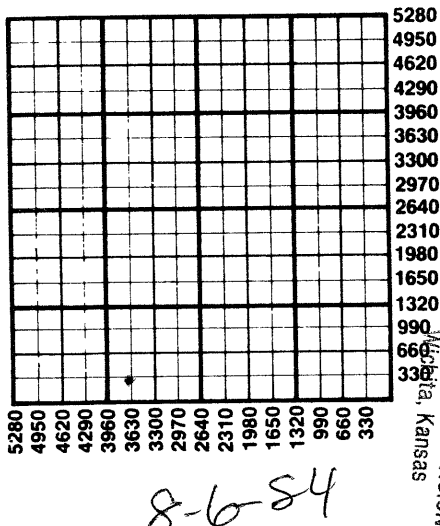

1. Notify District office before setting surface casing.
2. Set surface casing by circulating cement to the top.
3. File completion forms ACO-1 with K.C.C. within 90 days of well completion, following instructions on ACO-1, side 1, and including copies of wireline logs.
4. Notify District office 48 hours prior to old well workover or re-entry.
5. Prior to plugging, prepare a plugging plan, then obtain agreement from the appropriate district office for an approved plugging plan.
6. Submit plugging report (CP-4) to K.C.C. after plugging is completed.
7. Obtain an approved injection docket number before disposing of salt water.
8. Notify K.C.C. within 10 days when injection commences or terminates.
9. Obtain an alternate 2 completion, cement in the production pipe from below and pumpable water to surface within 120 days of spud date.

AUG 06 1984

RECEIVED
STATE CORPORATION COMMISSION

**State Corporation Commission of Kansas
Conservation Division
200 Colorado Derby Building
Wichita, Kansas 67202
(316) 263-3238**