

STATE CORPORATION COMMISSION OF KANSAS
OIL & GAS CONSERVATION DIVISION

WELL COMPLETION OR RECOMPLETION FORM
ACO-1 WELL HISTORY

DESCRIPTION OF WELL AND LEASE

Operator: license # 5562
name Liberty Enterprises, Inc.
address 308 West Mill
City/State/Zip Plainville, Kansas 67663

Operator Contact Person Charles G. Comeau
Phone 913-434-4686

Contractor: license # 5665
name Pioneer Drilling Company

Wellsite Geologist Greg Issinghoff
Phone 913-628-3503

Designate Type of Completion
 New Well Re-Entry Workover
 Oil SWD Temp Abd
 Gas Inj Delayed Comp.
 Dry Other (Core, Water Supply etc.)

If OWWO: old well info as follows:
Operator
Well Name
Comp. Date Old Total Depth

WELL HISTORY

Drilling Method: Mud Rotary Air Rotary Cable
12-8-82 12-14-82 4-2-85
Spud Date Date Reached TD Completion Date

3360' 2798'
Total Depth PBTD

Amount of Surface Pipe Set and Cemented at 8.5/8' @ 93' 13 3/8' @ 93'

Multiple Stage Cementing Collar Used? Yes No

If Yes, Show Depth Set feet

If alternate 2 completion, cement circulated from feet depth to w/ SX cmt

API No. 15-163-21,903-00-00

County Rooks

SE SW SW (location) Sec 24 Twp 7S Rge 18W East West

330 Ft North from Southeast Corner of Section
4290 Ft West from Southeast Corner of Section
(Note: locate well in section plat below)


Lease Name C.F. Rupp Well#5

Field Name

Producing Formation

Elevation: Ground 1777' KB 1782'

Section Plat

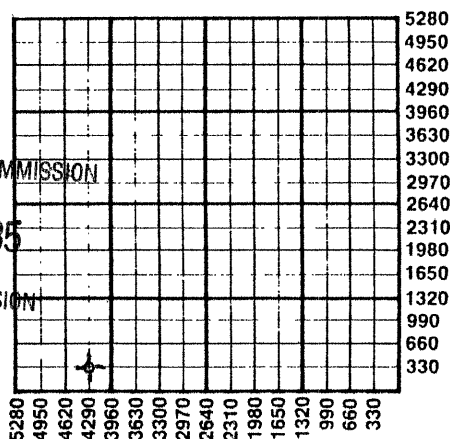

WATER SUPPLY INFORMATION

Source of Water:
Division of Water Resources Permit #

Groundwater Ft North From Southeast Corner and Ft West From Southeast Corner of Sec Twp Rge East West

Surface Water Ft North From Southeast Corner and Ft West From Southeast Corner of (Stream, Pond etc.) Sec Twp Rge East West

Other (explain) (purchased from city, R.W.D.#)

Disposition of Produced Water: Disposal Repressuring

Docket #

INSTRUCTIONS: This form shall be completed in duplicate and filed with the Kansas Corporation Commission, 200 Colorado Derby Building, Wichita, Kansas 67202, within 90 days after completion or recompletion of any well. Rules 82-3-130 and 82-3-107 apply.

Information on side two of this form will be held confidential for a period of 12 months if requested in writing and submitted with the form. See rule 82-3-107 for confidentiality in excess of 12 months.


One copy of all wireline logs and drillers time log shall be attached with this form. Submit CP-4 form with all plugged wells. Submit CP-111 form with all temporarily abandoned wells.

All requirements of the statutes, rules, and regulations promulgated to regulate the oil and gas industry have been fully complied with and the statements herein are complete and correct to the best of my knowledge.

Signature Charles G. Comeau
Title Petroleum Geologist Date 4-16-85

Subscribed and sworn to before me this 16th day of April 1985

Notary Public Jolene Garvert
Date Commission Expires

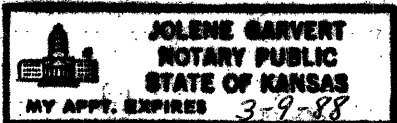

K.C.C. OFFICE USE ONLY
F Letter of Confidentiality Attached
C Wireline Log Received
C Drillers Timelog Received
Distribution
 KCC SWD/Rep NGPA
 KGS Plug Other (Specify)

Form ACO-1
(This form supercedes previous forms ACO-1 & C-10)

Sec. 24 Twp. 7 Rge. 18W

Operator Name .. Liberty Enterprises, Inc. Lease Name C.F. Rupp. Well# .5. SEC. 24. TWP. 7S. RGE. 18. East West

WELL LOG

INSTRUCTIONS: Show important tops and base of formations penetrated. Detail all cores. Report all drill stem tests giving interval tested, time tool open and closed, flowing and shut-in pressures, whether shut-in pressure reached static level, hydrostatic pressures, bottom hole temperature, fluid recovery, and flow rates if gas to surface during test. Attach extra sheet if more space is needed. Attach copy of log.

Drill Stem Tests Taken Yes No
 Samples Sent to Geological Survey Yes No
 Cores Taken Yes No

Formation Description
 Log Sample

Log Tops

Anhydrite 1212 (+570)
 Topeka 2713 (-931)
 Heebner 2922 (-1140)
 Toronto 2945 (-1163)
 Kansas City 2965 (-1183)
 Base/KC 3189 (-1407)
 Arbuckle 3320 (-1538)
 TD 3360 (-1578)

Name	Top	Bottom
sand	0'	94'
sand	94'	128'
sand and shale	128'	801'
sand and shale	801'	1172'
sand and shale	1172'	1205'
anhydrite	1205'	1212'
anhydrite	1212'	1240'
shales	1240'	1695'
shales	1695'	1742'
shales	1742'	1947'
shales and lime	1947'	2197'
shales and lime	2197'	2410'
lime and shales	2410'	2658'
sand and shales	2658'	2835'
shales and lime	2835'	2972'
lime and shales	2972'	3085'
shales and lime	3085'	3202'
shales and lime	3202'	3275'
arbuckle	3275'	3360'
	3360'	RTD

DST #1

3249-3361, recovered 900' muddy salt water
 Initial Hyd Mud 1949, 1st Initial F1 Press 105,
 1st Final F1 Press 355, Initial C1-In Press 1152,
 2nd Initial F1 Press 403, 2nd Final F1 Press 480,
 Final C1-In Press 1152, Final Hyd Mud 1872.

DST #2

2737-2770, recovered 540' mud, 180' muddy water
 Initial Hyd Mud 1563, 1st Initial F1 Press 163,
 1st Final F1 Press 298, Initial C1-In Press 1057,
 2nd Initial F1 Press 355, 2nd Final F1 Press 480,
 Final C1-In Press 951, Final Hyd Mud 1515

DST #3

2737-2830, recovered 600' mud, Initial Hyd Mud
 1554, 1st Initial F1 Press 192, 1st Final F1 Press
 298, Initial C1-In Press 1085, 2nd Initial F1
 Press 317, 2nd Final F1 Press 413, Final C1-In
 Press 1057, Final Hyd Mud 1554

CASING RECORD <input checked="" type="checkbox"/> new <input type="checkbox"/> used							
Report all strings set - conductor, surface, intermediate, production, etc.							
Purpose of string	size hole drilled	size casing set (in O.D.)	weight lbs/ft.	setting depth	type of cement	# sacks used	type and percent additives
Conductor String	17 1/4"	13.3/8"	54#	93'	common	110	2% gel, .3% cc
Long Surface	12 1/4"	8.5/8"	24#	1196.88'	60-40 pos.	75, 375	Q-set, 3% gel, 4% cc
Production	7.7/8"	4 1/2"	10.5#	2799'	A.S.C.	100	500 bbl. soap flush
PERFORATION RECORD				Acid, Fracture, Shot, Cement Squeeze Record			
shots per foot	specify footage of each interval perforated			(amount and kind of material used)			Depth
4 per 1'	2744-2746			1000 gal. 15% acid w/200,000 scf. of nitrogen, non commercial			2744-2746
TUBING RECORD				Liner Run <input type="checkbox"/> Yes <input type="checkbox"/> No			
Date of First Production	Producing method <input type="checkbox"/> flowing <input type="checkbox"/> pumping <input type="checkbox"/> gas lift <input type="checkbox"/> Other (explain)						
Estimated Production Per 24 Hours	Oil	Gas	Water	Gas-Oil Ratio	Gravity		
	Bbls	MCF	Bbls	CFPB			

Disposition of gas: vented open hole perforation
 sold other (specify) _____
 used on lease

