

15-163-20113-00-00

STATE OF KANSAS
STATE CORPORATION COMMISSION

Give All Information Completely
Make Required Affidavit
Mail or Deliver Report to:
Conservation Division
State Corporation Commission
212 No. Market
Wichita, Kansas

WELL PLUGGING RECORD

Rooks County. Sec. 25 Twp. 7S Rge. (E) 18 (W)

Location as "NE/CNW/SW" or footage from lines SW SW SW

Lease Owner CAMERON K. REED

Lease Name SENIOR Well No. 1

Office Address 20 WEST 9TH ST., KANSAS CITY, MISSOURI

Character of Well (completed as Oil, Gas or Dry Hole) DRY HOLE

Date well completed JUNE 22, 19 68

Application for plugging filed (PHONE 6/22/68) JUNE 27, 19 68

Application for plugging approved JUNE 22, 19 68


Plugging commenced JUNE 22, 19 68

Plugging completed JUNE 22, 19 68

Reason for abandonment of well or producing formation

If a producing well is abandoned, date of last production 19

Was permission obtained from the Conservation Division or its agents before plugging was commenced? YES

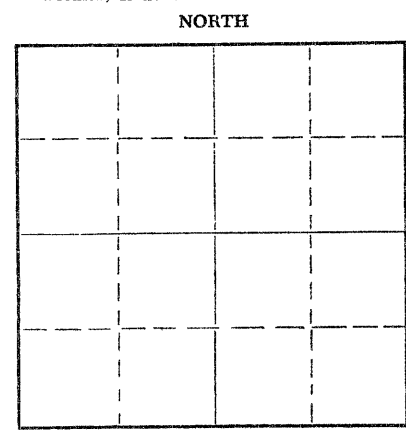

Locate well correctly on above Section Plat

Name of Conservation Agent who supervised plugging of this well LEO MASSEY

Producing formation Depth to top Bottom Total Depth of Well 3360 Feet

Show depth and thickness of all water, oil and gas formations.

OIL, GAS OR WATER RECORDS

CASING RECORD

FORMATION	CONTENT	FROM	TO	SIZE	PUT IN	PULLED OUT
		0	200	8-5/8"	200'	NONE

Describe in detail the manner in which the well was plugged, indicating where the mud fluid was placed and the method or methods used in introducing it into the hole. If cement or other plugs were used, state the character of same and depth placed, from feet to feet for each plug set.

HOOKED ON TO SURFACE PIPE AND USED PUMP TRUCK TO SQUEEZE WELL. PLUGGED WITH 2 SACKS HULLS, 130 SACKS OF CEMENT (POZMIS - 6% GEL). JOB COMPLETE @ 6:30 A.M., JUNE 22, 1968.

RECEIVED
STATE CORPORATION COMMISSION
JUN 28 1968
CONSERVATION DIVISION
Wichita, Kansas

6-28-68

(If additional description is necessary, use BACK of this sheet)

Name of Plugging Contractor GABBERT-JONES, INC.
Address 830 SUTTON PLACE - WICHITA, KANSAS

STATE OF KANSAS, COUNTY OF SEDGWICK, ss.
E. E. HALL (employee of owner) or (owner or operator) of the above-described

well, being first duly sworn on oath, says: That I have knowledge of the facts, statements, and matters herein contained and the log of the above-described well as filed and that the same are true and correct. So help me God.

(Signature) E. E. Hall

830 SUTTON PLACE, WICHITA, KANSAS (Address)

SUBSCRIBED AND SWORN TO before me this 27 day of JUNE, 19 68

Barbara J. Layton
BARBARA J. LAYTON Notary Public.

FEBRUARY 1, 1972

