


15-163-21838-00-00

STATE OF KANSAS  
STATE CORPORATION COMMISSION

WELL PLUGGING RECORD

Give All Information Completely  
Make Required Affidavit  
Mail or Deliver Report to  
Conservation Division  
State Corporation Comm.  
245 North Water  
Wichita, KS 67202

Rooks County. Sec. 36 Twp. 7S Rge. 18W ~~E~~W  
Location as "NE/CNW $\frac{1}{2}$ /SW $\frac{1}{2}$ " or footage from lines

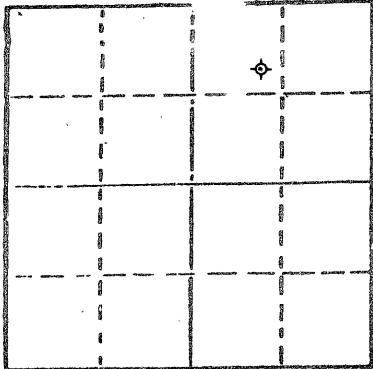

Locate well correctly on above  
Section Plot

SE NW NE  
Lease Owner F & M OIL CO., INC.  
Lease Name Kansas "B" Well No. 1  
Office Address 422 Union Center, Wichita, Ks. 67202  
Character of Well (Completed as Oil, Gas or Dry Hole) Dry

Date Well completed November 19, 1982  
Application for plugging filed November 19, 1982  
Application for plugging approved November 19, 1982  
Plugging commenced November 19, 1982  
Plugging completed November 19, 1982  
Reason for abandonment of well or producing formation Dry

If a producing well is abandoned, date of last production 19

Was permission obtained from the Conservation Division or its agents before plugging was commenced? Yes

Name of Conservation Agent who supervised plugging of this well Marion Schmidt  
Producing formation Depth to top Bottom Total Depth of Well 3523'  
Show depth and thickness of all water, oil and gas formations.

OIL, GAS OR WATER RECORDS

CASING RECORD

FORMATION	CONTENT	FROM	TO	SIZE	PUT IN	PULLED OUT

Describe in detail the manner in which the well was plugged, indicating where the mud fluid was placed and the method or methods used in introducing it into the hold. If cement or other plugs were used, state the character of same and depth placed, from feet to feet for each plug set.

Set 1st plug @ 3520' w/20 sxs  
Set 2nd plug @ 1324' w/100 sxs  
Set 3rd plug @ 300' w/40 sxs  
Set 4th plug @ 40' w/10 sxs  
10 sxs in the rat hole, 50/50 posmix, 4% gel, 3% CC  
plug down @ 11 AM 11-19-82

(If additional description is necessary, use BACK of this sheet)

Name of Plugging Contractor Union Drilling Co., Inc.

STATE OF Kansas COUNTY OF Sedgwick, ss.  
R. D. Messenger (employee of owner) or (owner or operator)  
of the above-described well, being first duly sworn on oath, says: That I have knowledge of the facts, statements, and matters herein contained and the log of the above-described well as filed and that the same are true and correct. So help me God.

(Signature) *R. D. Messenger*  
422 Union Center, Wichita, Ks. 67202  
(Address)

SUBSCRIBED AND SWORN TO before me this 7th day of December, 1982  
My commission expires 12-24-84  
*Shirley A. Gallegos*  
Shirley A. Gallegos  
Notary Public.

