


15-163-00457-00-00

STATE OF KANSAS
STATE CORPORATION COMMISSION

Give All Information Completely
Make Required Affidavit
Mail or Deliver Report to:
Conservation Division
State Corporation Commission
800 Bitting Building
Wichita, Kansas

WELL PLUGGING RECORD

NORTH

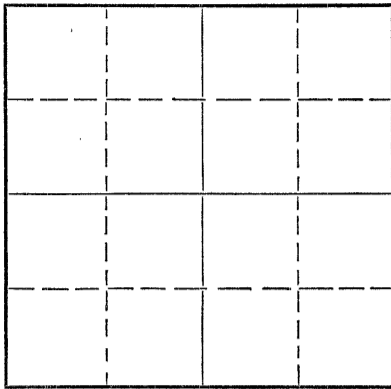

Locate well correctly on above
Section Plat

ROOKS County. Sec. 35 Twp. 7 Rge. 18 (E) W (W)
Location as "NE/CNW $\frac{1}{4}$ /SW $\frac{1}{4}$ " or footage from lines SE SW NE
Lease Owner JOHN LINDAS OIL, Inc.
Lease Name ROELES Well No. 1
Office Address 1316 Union National Bank Bldg., Wichita, Kansas
Character of Well (completed as Oil, Gas or Dry Hole) Dry
Date well completed June 23 19 52
Application for plugging filed June 23 19 52
Application for plugging approved June 23 19 52
Plugging commenced 6-23-52 19
Plugging completed 6-23-52 @ 10:00 p.m. 19
Reason for abandonment of well or producing formation Dry

If a producing well is abandoned, date of last production 19
Was permission obtained from the Conservation Division or its agents before plugging was commenced? Yes

Name of Conservation Agent who supervised plugging of this well Eldon Petty
Producing formation Depth to top Bottom Total Depth of Well 3399 Feet
Show depth and thickness of all water, oil and gas formations.

OIL, GAS OR WATER RECORDS

CASING RECORD

Formation	Content	From	To	Size	Put In	Pulled Out

Describe in detail the manner in which the well was plugged, indicating where the mud fluid was placed and the method or methods used in introducing it into the hole. If cement or other plugs were used, state the character of same and depth placed, from feet to feet for each plug set.

Filled hole with mud to 190'. Set Plug and 15 sacks cement. Plug at 40'
1/2 sacks hulls and 10 sacks cement.

(If additional description is necessary, use BACK of this sheet)

Name of Plugging Contractor John Lindas Oil, Inc.
Address 1316 Union National Bank Building; Wichita 2, Kansas

STATE OF KANSAS, COUNTY OF SEDGWICK, ss.

I, B. L. Gilmer (employee of owner) of the above-described well, being first duly sworn on oath, says: That I have knowledge of the facts, statements, and matters herein contained and the log of the above-described well as filed and that the same are true and correct. So help me God.

(Signature) *B. L. Gilmer*

Production Supt. 1316 U. N. B. Bldg.
Wichita 2, Kansas

SUBSCRIBED AND SWORN to before me this 25th day of June, 19 52

Edward W. Wiers
Notary Public.

My commission expires October 8, 1955

23-8390-s 6-51-20M
357 7 18w
BOOK PAGE 26

6-25-52