


STATE OF KANSAS
STATE CORPORATION COMMISSION

15-163-19075-00-00

WELL PLUGGING RECORD

Give All Information Completely
Make Required Affidavit
Mail or Deliver Report to:
Conservation Division
State Corporation Commission
800 Bitting Building
Wichita, Kansas

NORTH

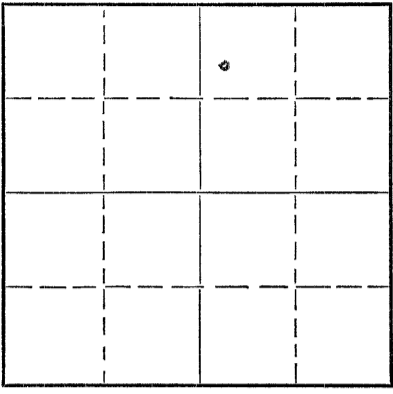

Locate well correctly on above Section Plat

Rooks..... County. Sec. 31 Twp. 7S Rge. (E) 18 (W)
 Location as "NE/CNW $\frac{1}{4}$ SW $\frac{1}{4}$ " or footage from lines 2310' W. of EL, 990' S. of NL
 Lease Owner Gulf Oil Corporation
 Lease Name P. J. Zilinger Well No. 1
 Office Address Box 661 Tulsa, Oklahoma
 Character of Well (completed as Oil, Gas or Dry Hole) Dry hole
 Date well completed April 20 1953
 Application for plugging filed April 22 1953
 Application for plugging approved April 22 1953
 Plugging commenced April 22 1953
 Plugging completed April 22 1953
 Reason for abandonment of well or producing formation Dry Hole
 If a producing well is abandoned, date of last production _____ 19____
 Was permission obtained from the Conservation Division or its agents before plugging was commenced? Yes

Name of Conservation Agent who supervised plugging of this well Eldon Petty
 Producing formation Arbuckle Depth to top 3301' Bottom 3410' Total Depth of Well 3410' Feet
 Show depth and thickness of all water, oil and gas formations.

OIL, GAS OR WATER RECORDS

CASING RECORD

| Formation | Content | From | To | Size | Put In | Pulled Out |
|-----------|---------|------|----|---------|--------|------------|
| | | | | 13-3/8" | 37' | None |
| | | | | 8-5/8" | 1298' | None |
| | | | | | | |
| | | | | | | |
| | | | | | | |
| | | | | | | |
| | | | | | | |
| | | | | | | |
| | | | | | | |

Describe in detail the manner in which the well was plugged, indicating where the mud fluid was placed and the method or methods used in introducing it into the hole. If cement or other plugs were used, state the character of same and depth placed, from _____ feet to _____ feet for each plug set.

Pumped 100 sacks bulk cement by Halliburton Oil Well Cementing Company into 8-5/8" surface pipe. Maximum pressure 500#, final pressure 200#.
Hole below cement plug is full of 40 Viscosity drilling mud.

(If additional description is necessary, use BACK of this sheet)

Name of Plugging Contractor Anschutz Drilling Company
 Address 709 Union National Bank Building
Wichita, Kansas

STATE OF Kansas, COUNTY OF Rice, ss.
W. H. Duley (employee of owner) or ~~owner or operator~~ of the above-described well, being first duly sworn on oath, says: That I have knowledge of the facts, statements, and matters herein contained and the log of the above-described well as filed and that the same are true and correct. So help me God.

(Signature) W. H. Duley
Box 544 Chase, Kansas
 (Address)

SUBSCRIBED AND SWORN to before me this 26th day of May, 1953
W. H. Duley Notary Public.

My commission expires April 14, 1956
 23-8390-s 6-51-20M

PLUGGING
 FILE SEC 31 T 7 R 18W
 BOOK PAGE 95 LINE 25

RECEIVED
 STATE CORPORATION COMMISSION
 MAY 27 1953 5-27-53
 CONSERVATION DIVISION
 Wichita, Kansas