

STATE CORPORATION COMMISSION OF KANSAS  
OIL & GAS CONSERVATION DIVISION  
WELL COMPLETION OR RECOMPLETION FORM  
ACO-1 WELL HISTORY  
DESCRIPTION OF WELL AND LEASE

API NO. 15-163-22-873-00-00  
County Rooks  
NW NE SE Sec. 25 Twp. 7S Rge. 18 East  
X West

Operator: License # 8925  
Name Liberty Operations & Completions, Inc.  
Address 308 West Mill Inc.  
City/State/Zip Plainville, Ks. 67663

2300 Ft North from Southeast Corner of Section  
960 Ft West from Southeast Corner of Section  
(Note: Locate well in section plat below)

Purchaser Farmland Industries, Inc.

Lease Name Jayhawk Well # 1

Operator Contact Person Charles G. Comeau  
Phone 913-434-4686

Field Name Riffe


Producing Formation Arbuckle

Contractor: License # 5665  
Name Pioneer Drilling Company, Inc.

Elevation: Ground 1882' KB. 1887'

Wellsite Geologist Chris Mraz  
Phone 913-434-4686

Section Plat

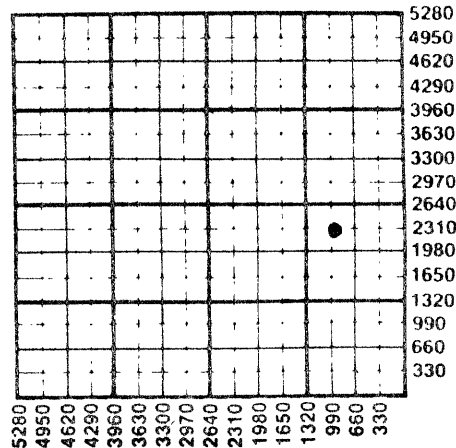

Designate Type of Completion  
X New Well Re-Entry Workover  
X Oil SWD Temp Abd  
Gas Inj Delayed Comp.  
Dry Other (Core, Water Supply etc.)

If OWWO: old well info as follows:  
Operator  
Well Name  
Comp. Date Old Total Depth

WELL HISTORY

Drilling Method:  
X Mud Rotary Air Rotary Cable  
2-17-86 2-25-86 3-25-86  
Spud Date Date Reached TD Completion Date  
3395' 3384'  
Total Depth PBTD

Amount of Surface Pipe Set and Cemented at 8 5/8" @ 273' feet  
Multiple Stage Cementing Collar Used? X Yes No  
If yes, show depth set 1187' feet  
If alternate 2 completion, cement circulated from feet depth to w/ SX cmt  
Cement Company Name Allied Cementing Co., Inc.  
Invoice # 46156

WATER SUPPLY INFORMATION

Disposition of Produced Water: Disposal  
Docket # Repressuring

Questions on this portion of the ACO-1 call:

Water Resources Board (913) 296-3717  
Source of Water: Pond water & City water  
Division of Water Resources Permit #  
Groundwater Ft North from Southeast Corner (Well) Ft West from Southeast Corner of Sec Twp Rge East West  
X Surface Water Ft North from Southeast Corner (Stream, pond etc) Ft West from Southeast Corner Sec Twp Rge East West  
X Other (explain) from City of Stockton (purchased from city, R.W.D. #)

INSTRUCTIONS: This form shall be completed in duplicate and filed with the Kansas Corporation Commission, 200 Colorado Derby Building, Wichita, Kansas 67202, within 90 days after completion or recompletion of any well. Rule 82-3-130 and 82-3-107 apply.  
Information on side two of this form will be held confidential for a period of 12 months if requested in writing and submitted with the form. See rule 82-3-107 for confidentiality in excess of 12 months.  
One copy of all wireline logs and drillers time log shall be attached with this form. Submit CP-4 form with all plugged wells. Submit CP-111 form with all temporarily abandoned wells.

All requirements of the statutes, rules and regulations promulgated to regulate the oil and gas industry have been fully complied with and the statements herein are complete and correct to the best of my knowledge.

Signature Charles G. Comeau  
Title Petroleum Geologist Date 4/9/86  
Subscribed and sworn to before me this 9th day of April 1986  
Notary Public Jolene Garvert  
Date Commission Expires 3-9-88

K.C.C. OFFICE USE ONLY  
Letter of Confidentiality Attached  
Wireline Log Received  
Drillers Timelog Received  
Distribution  
KCC SWD/Rep NGPA  
KGS Plug Other  
(Specify)

JOLENE GARVERT  
NOTARY PUBLIC  
STATE OF KANSAS  
MY APPT. EXPIRES 3-9-88  
APR 10 1986  
KANSAS CORPORATION COMMISSION  
Wichita, Kansas

4-10-86

Sec 25 Twp. 7 Rge. 18