

KANSAS CORPORATION COMMISSION
OIL & GAS CONSERVATION DIVISION
WELL PLUGGING APPLICATION
Please TYPE Form and File ONE Copy

Form CP-1
September 2003
This Form must be Typed
Form must be Signed
All blanks must be Filled

API # 15 - 093-20352 - DD - 00 (Identifier Number of this well). This must be listed for wells drilled since 1967; if no API # was issued,

indicate original spud or completion date spud 11/24/76

Well Operator: XTO Energy, Inc. KCC License #: 32864

Address: 210 Park Ave., Suite 2350 City: Oklahoma City

State: Oklahoma Zip Code: 73102 Contact Phone: (405) 319 - 3212

Lease: Masonic Home Well #: 3-2 Sec. 36 Twp. 25 S. R. 36 East West

NE - NE - NE - SW Spot Location / QQQQ County: Kearny

2520' Feet (in exact footage) From North / South (from nearest outside section corner) Line of Section (Not Lease Line)

2540' Feet (in exact footage) From East / West (from nearest outside section corner) Line of Section (Not Lease Line)

Check One: Oil Well Gas Well D&A Cathodic Water Supply Well
 SWD Docket # _____ ENHR Docket # _____ Other: _____

Conductor Casing Size: N/A Set at: _____ Cemented with: _____ Sacks

Surface Casing Size: 8 5/8" Set at: 535' Cemented with: 300 Sacks

Production Casing Size: 5 1/2" Set at: 2999' Cemented with: 700 Sacks

List (ALL) Perforations and Bridgeplug Sets: Council Grove perms 2724' - 40', 2770' - 74', 2778' - 82', 2812' - 16', 2828' - 32', 2838' - 46'

Elevation: 3032' (G.L. / K.B.) T.D.: 3010' PBD: 3006' Anhydrite Depth: 1238'
(Stone Corral Formation)

Condition of Well: Good Poor Casing Leak Junk in Hole

Proposed Method of Plugging (attach a separate page if additional space is needed): Fill hole w/ 9# mud, set BP +/- 50' of perms w/100' cmt on top, surface csg 200' cement plug from 435' - 635', surface plug from 34' to 4'.

Is Well Log attached to this application as required? Yes No Is ACO-1 filed? Yes No
If not explain why? Not available unknown

Plugging of this Well will be done in accordance with K.S.A. 55-101 et. seq. and the Rules and Regulations of the State Corporation Commission.

List Name of Company Representative authorized to be in charge of plugging operations: David Littell or Mark Gosch

Phone: (620) 355 - 7838

Address: 805 S. Hwy 25 City / State: Lakin, KS 67860

Plugging Contractor: Sargent & Horton KCC License #: 31151

Address: RT-1, Box 49 BA, Tyrone, DK. 73951-9731 Phone: (580) 854 - 6515

Proposed Date and Hour of Plugging (if known?): Unknown at present

Payment of the Plugging Fee (K.A.R. 82-3-118) will be guaranteed by Operator or Agent

Date: 10/13/05 Authorized Operator / Agent: Karen Byers
(Signature)

Mail to: KCC - Conservation Division, 130 S. Market - Room 2078, Wichita, Kansas 67202

Rec'd
10-31-05

4/06

1/06


DEC 17 1976

12-8-76

RECEIVED
 OCT 31 2005
 KCC WICHITA

Kearney	36	25s	36w	2520'FSL	2540FWL
COUNTY	S	T	R	LOCATION	DATE
Kansas-Nebraska				3-2	Masonic Home
OPERATOR				NO.	FARM
					3041 gr.
				ELEVATION:	

SCALE: 2"=1mile

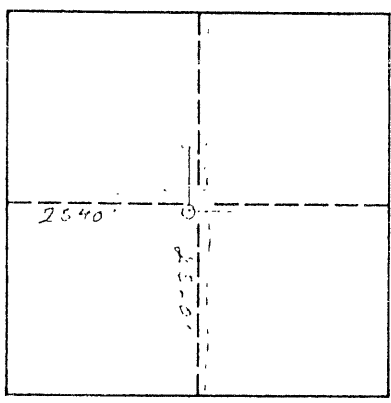

Please Note this
is Restake on this
 Location as request
 by Dan REINEKE

MINIMUM STAKING CHARGE: \$85.00
 (INCLUDES GROUND ELEVATION)
 EXTRA TIME & MILEAGE: _____
 ELEVATION CHARGE: _____
 TOTAL: \$85.00

Vernon C Becker
 L-S SURVEYOR

Laughlin-Simmons & Co. of Kansas, Inc. is not liable in case of errors and/or omissions.

KANSAS

CORPORATION COMMISSION

Kathleen Sebelius, Governor Brian J. Moline, Chair Robert E. Krehbiel, Commissioner Michael C. Moffet, Commissioner

NOTICE OF RECEIPT OF WELL PLUGGING APPLICATION (CP-1)

XTO Energy Inc.
210 Park Avenue - Suite 2350
Oklahoma City, OK 73102

November 14, 2005

Re: MASONIC HOME #3-2
API 15-093-20352-00-00
NENENESW 36-25S-36W, 2520 FSL 2540 FWL
KEARNY COUNTY, KANSAS

Dear Operator:

This letter is to notify you that the Conservation Division is in receipt of your plugging proposal, form CP-1, for the above-captioned well.

Your CP-1 has been reviewed by the Conservation Division central office for completeness and to verify license numbers. The plugging proposal will now be forwarded to the district office listed below for review of your proposed method of plugging.


Please contact the district office for approval of your proposed plugging method at least five (5) days before plugging the well, pursuant to K.A.R. 82-3-113 (b). If a workover pit will be used during the plugging of the well it must be permitted. A CDP-1 form must be filed and approved prior to the use of the pit.

The Conservation Division's review of form CP-1, either in the central or district office, does not include an inquiry into well ownership or the filing operator's legal right to plug the well.

This notice in no way constitutes authorization to plug the above-captioned well by persons not having legal rights of ownership or interest in the well. This notice is void after ninety (90) days from the above date.

District: #1
210 E Frontview, Suite A
Dodge City, KS 67801
(620) 225-8888

Sincerely

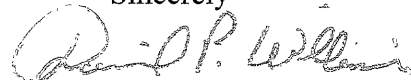

David P. Williams
Production Supervisor