

STATE OF KANSAS
 STATE CORPORATION COMMISSION
 200 Colorado Derby Bldg.
 Wichita, Kansas 67202


Form CP-4
 Rev. 12-15-80

WELL PLUGGING RECORD

Give All Information Completely
 Make Required Affidavit

15-163-22123-00-00

COUNTY Rooks SEC. 7 TWP. 7 RGE. 20 E/W
 Location as in quarters or footage from lines:
NE-SE-NE

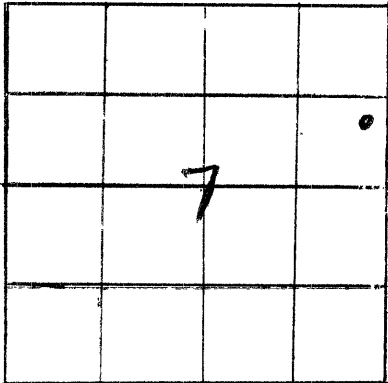

Locate Well
 correctly on above
 Section Platt.

Lease Owner Alcona Oil Company
 Lease Name Loeffler #1 Well No. #1
 Office Address Rt. 2, Box 51, Stockton, Kansas 67669
 Character of Well (Completed as Oil, Gas or Dry Hole): Oil
 Date Well Completed 11-7-83
 Application for plugging filed 4-25-84
 Plugging commenced 4-26-84
 Plugging completed 5-11-84
 Reason for abandonment of well or producing formation Little to no production
 Was permission obtained from the Conservation Division or it's Agent's before plugging was commenced? Yes

Name of Conservation Agent who supervised plugging of this well Dennis Hamel
 Producing formation L/KC & Arb Depth to top 3426' bottom 3628' T.D. 3652'
 Show depth and thickness of all water, oil and gas formations.

OIL, GAS OR WATER RECORDS Casing Record


Formation	Content	From	To	Size	Put in	Pulled Out
Surface Casing				8 5/8"	267'	
Casing				4 1/2"	3,652'	1,425'

Describe in detail the manner in which the well was plugged, indicating where the mud fluid was placed and the method or methods used in introducing it into the hold. If cement or other plugs were used, state the character of same and depth placed, from _____ feet to _____ feet for each plug set. Dumped 4 sacks cement on bottom with bailer. Dumped 45 buckets sand. Let set 2 hours. Dumped rock bridge and 4 sacks cement. 3250' TD. Pulled 1,425' of 4 1/2" casing.
Mixed 3 sacks hulls, 10 sacks gel w/hulls, 100 sacks cement w/hulls, 10 sacks gel, released plug, mixed 50 sacks cement and put in at 500 PSI, shut in at 100 PSI.

RECEIVED
 STATE CORPORATION COMMISS
 JUN 05 1984
 06-05-1984
 CONSERVATION DIVISION
 Wichita, Kansas

(If additional description is necessary, use BACK of this sheet)
 Name of Plugging Contractor Chase Well Service, Inc. plugged the bottom.
Allied Cementing Co. Inc. plugged the upper portion.

STATE OF Kansas COUNTY OF Rooks, ss.
Alcona Oil Co. (employee of owner) or (owner or operator) of the above-described well, being first duly sworn on oath, says: That I have knowledge of the facts, statements, and matters herein contained and the log of the above-described well as filed and that the same are true and correct. So help me God.
 (Signature) Dean de Saal
Rt. 2, Box 51, Stockton, Mo.
 (Address)

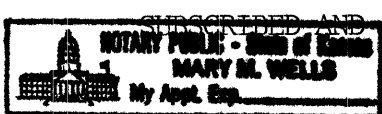

SUBSCRIBED AND SWORN TO before me this 4th day of June, 19 84
Mary M. Wells
 Notary Public.
 My Commission expires: June 19, 1986