

CARD MUST BE TYPED

State of Kansas
NOTICE OF INTENTION TO DRILL
 (see rules on reverse side)

CARD MUST BE SIGNED

Starting Date: 6-15-85
 month day year

API Number 15-

163-22,702-0000

OPERATOR: License # 9476 (9476)

NE SE NW Sec 25. Twp 7... S, Rge 18. ☐ East
☒ West

Name G-D Oil Operations Glen Drotts (DGA)

(location)

Address P.O. Box 441

3630

Ft North from Southeast Corner of Section

City/State/Zip Hays, KS 67601

2970

Ft West from Southeast Corner of Section

Contact Person Glen Drotts

(Note: Locate well on Section Plat on reverse side)

Phone 913-628-3560

Nearest lease or unit boundary line 330 feet.

CONTRACTOR: License # 9087

County Rooks

Name R. & C. Drilling Co., Inc.

Lease Name Hazen Well# 1

City/State Hays, Kansas

Domestic well within 330 feet: ☐ yes ☒ noMunicipal well within one mile: ☒ yes ☐ no

Well Drilled For:

Well Class:

Type Equipment:

☒ Oil ☐ Swd☐ Infield☒ Mud Rotary☐ Gas ☐ Inj☒ Pool Ext.☐ Air Rotary☐ OWWO ☐ Expl☐ Wildcat☐ Cable

If OWWO: old well info as follows:

Operator

Well Name

Comp Date Old Total Depth

Projected Total Depth 3450 feet

Projected Formation at TD Arbuckle

Expected Producing Formations Arbuckle

Depth to Bottom of fresh water 100 feet

Lowest usable water formation Dakota

Depth to Bottom of usable water 900 feet

Surface pipe by Alternate: 1 ☒ 2 ☐

Surface pipe to be set 1000 1200 mHe feet

Conductor pipe if any required 80 feet

Ground surface elevation NA - Est. 1250 feet MSL

This Authorization Expires 12-3-85

Approved By 6-3-85 R

I certify that we will comply with K.S.A. 55-101, et seq., plus eventually plugging hole to K.C.C. specifications. Production string will be immediately cemented.

Date 5-31-85 Signature of Operator or Agent

R. L. Finney

Title R. L. Finney, Contractor


Form C-1 4/84

MHC/KOHE 6-3-85

**Must be filed with the K.C.C. five (5) days prior to commencing well
This card void if drilling not started within six (6) months of date received by K.C.C.**

Important procedures to follow :

**A Regular Section of Land
1 Mile = 5,280 Ft.**

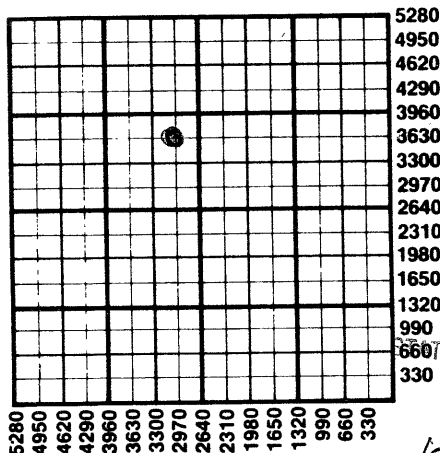

1. Notify District office before setting surface casing.
2. Set surface casing by circulating cement to the top.
3. File completion forms ACO-1 with K.C.C. within 90 days of well completion, following instructions on ACO-1, side 1, and including copies of wireline logs.
4. Notify District office 48 hours prior to old well workover or re-entry.
5. Prior to plugging, prepare a plugging plan, then obtain agreement from the appropriate district office for an approved plugging plan.
6. Submit plugging report (CP-4) to K.C.C. after plugging is completed.
7. Obtain an approved injection docket number before disposing of salt water.
8. Notify K.C.C. within 10 days when injection commences or terminates.
9. If an alternate 2 completion, cement in the production pipe from below any usable water to surface within 120 days of spud date.

RECEIVED
JUN 03 1985
6-3-85
CONSERVATION DIVISION
Wichita, Kansas

**State Corporation Commission of Kansas
Conservation Division
200 Colorado Derby Building
Wichita, Kansas 67202
(316) 263-3238**