

P CARD MUST BE TYPED

State of Kansas

CARD MUST BE SIGNED ✓

# NOTICE OF INTENTION TO DRILL

(see rules on reverse side)

Expected Spud Date OCTOBER... 14... 1987  
month day year

API Number 15— 163-22,954-00-00

OPERATOR: License # #6111

NE NW SE Sec. 7 Twp. 7 S, Rg. 20 X East West

Name N. B. COMPANY, INC.

2310 Ft. from South Line of Section

Address P. O. BOX 506

1650 Ft. from East Line of Section

City/State/Zip RUSSELL, KS 67665

(Note: Locate well on Section Plat on reverse side)

Contact Person KYLE B. BRANUM

Nearest lease or unit boundary line 330 feet

Phone 913-483-5345

County ROOKS

CONTRACTOR: License # #8241

Lease Name LeSage Well # 1

Name EMPHASIS OIL OPERATIONS

Ground surface elevation 2100 feet MSL

City/State RUSSELL, KS 67665

Domestic well within 330 feet:     yes X no

Well Drilled For: Well Class: Type Equipment:

Municipal well within one mile:     yes X no

X Oil     Storage     Infield X Mud Rotary

Depth to bottom of fresh water 40

    Gas     Inj X Pool Ext.     Air Rotary

Depth to bottom of usable water 100

    OWWO     Expl     Wildcat     Cable

Surface pipe by Alternate:     1 2 X

If OWWO: old well info as follows:

Surface pipe planned to be set 200

Operator .....

Conductor pipe required .....

Well Name .....

Projected Total Depth 3650 feet

Comp Date ..... Old Total Depth .....

Formation ARBUCKLE

I certify that well will comply with K.S.A. 55-101, et seq., plus eventually plugging hole to KCC specifications.

Date 9/09/87 Signature of Operator or Agent Annitta Betts Title AS AGENT

For KCC Use:

Conductor Pipe Required ..... feet; Minimum Surface Pipe Required 200 feet per Alt. 1 2

This Authorization Expires 9-9-88 Approved By DG 10-9-87


Effective Date: 10-14-87

Must be filed with the K.C.C. five (5) days prior to commencing well  
 This card void if drilling not started within six (6) months of date received by K.C.C.

**Important procedures to follow:**

1. Notify District office before setting surface casing.
2. Set surface casing by circulating cement to the top.
3. File completion forms ACO-1 with K.C.C. within 120 days of well spud date, following instructions on ACO-1, side 1, and including copies of wireline logs.
4. Notify District office 48 hours prior to old well workover or re-entry.
5. Prior to filing Intent, prepare a proposed plugging plan in case well is D & A, then obtain approval of plan when calling district office prior to setting surface pipe.
6. Submit plugging report (CP-4) to K.C.C. after plugging is completed.
7. Obtain an approved injection dock number before disposing of salt water.
8. Notify K.C.C. within 10 days when injection commences or terminates.
9. If an alternate 2 completion, cement in the production pipe from below any usable water to surface within 120 days of spud date.

**A Regular Section of Land  
 1 Mile = 5,280 Ft.**

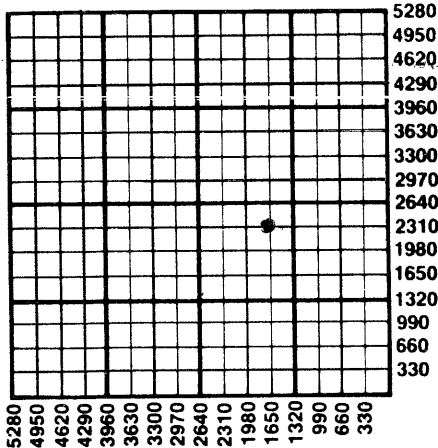

10-09-1987

State Corporation Commission of Kansas  
 Conservation Division  
 200 Colorado Derby Building  
 Wichita, Kansas 67202-1212  
 (316) 263-3238

RECEIVED  
 STATE CORPORATION COMMISSION  
 CONSERVATION DIVISION  
 WICHITA, KANSAS  
 9 1987