

CARD MUST BE TYPED

State of Kansas
NOTICE OF INTENTION TO DRILL
(see rules on reverse side)

CARD MUST BE SIGNED

Starting Date: 1 2 85
month day year

API Number 15- 163-22,600-00-00

OPERATOR: License # 5900

SW SE SE Sec 8 Twp 7s S, Rge 20 East West

Name Lawbanco Drilling, Inc.

Address Box 289

City/State/Zip Natoma, Kansas 67651

Contact Person Reva Musgrove

Phone 913-885-4676

330 Ft North from Southeast Corner of Section
990 Ft West from Southeast Corner of Section
(Note: Locate well on Section Plat on reverse side)

CONTRACTOR: License # 9087

Name R & C Drilling Co., Inc.

City/State Hays, Kansas 67601

Nearest lease or unit boundary line 330 feet.
County Rooks
Lease Name LeSage Well# 1

Domestic well within 330 feet: yes no

Municipal well within one mile: yes no

Well Drilled For: Well Class: Type Equipment:

Oil Swd Infield Mud Rotary

Gas Inj Pool Ext. Air Rotary

OWWO Expl Wildcat Cable

Depth to Bottom of fresh water 100 feet

Lowest usable water formation Dakota

Depth to Bottom of usable water 1125 feet

Surface pipe by Alternate: 1 2

Surface pipe to be set 200 feet

Conductor pipe if any required none feet

Ground surface elevation Est. 2160 feet MSL

This Authorization Expires 6-26-85

Approved By RCH/KCC 12-26-84

If OWWO: old well info as follows:

Operator

Well Name

Comp Date Old Total Depth

Projected Total Depth 3500 feet

Projected Formation at TD Arbuckle

Expected Producing Formations Toronto Kansas City

I certify that we will comply with K.S.A. 55-101, et seq., plus eventually plugging hole to K.C.C. specifications.

Date 12-21-84 Signature of Operator or Agent

Reva F. Musgrove Title Bookkeeper

MHC/UDHE 12/26/84 Form C-1 4/84


RECEIVED
STATE CORPORATION COMMISSION

Must be filed with the K.C.C. five (5) days prior to commencing well
This card void if drilling not started within six (6) months of date received by K.C.C.

DEC 26 1984

12-26-1984

CONSERVATION DIVISION
Wichita, Kansas
Regular Section of Land
1 Mile **5,280 Ft.**

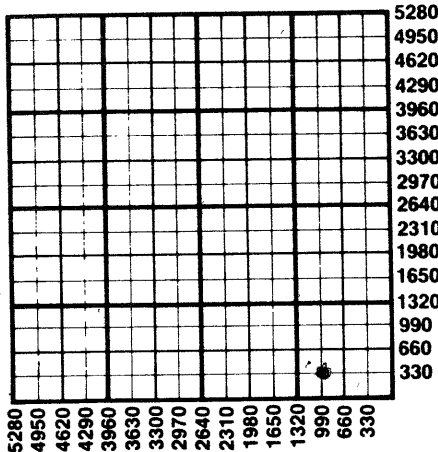

Important procedures to follow :

1. Notify District office before setting surface casing.
2. Set surface casing by circulating cement to the top.
3. File completion forms ACO-1 with K.C.C. within 90 days of well completion, following instructions on ACO-1, side 1, and including copies of wireline logs.
4. Notify District office 48 hours prior to old well workover or re-entry.
5. Prior to plugging, prepare a plugging plan, then obtain agreement from the appropriate district office for an approved plugging plan.
6. Submit plugging report (CP-4) to K.C.C. after plugging is completed.
7. Obtain an approved injection docket number before disposing of salt water.
8. Notify K.C.C. within 10 days when injection commences or terminates.
9. If an alternate 2 completion, cement in the production pipe from below any usable water to surface within 120 days of spud date.

State Corporation Commission of Kansas
Conservation Division
200 Colorado Derby Building
Wichita, Kansas 67202
(316) 263-3238