

CARD MUST BE TYPED

State of Kansas  
**NOTICE OF INTENTION TO DRILL**  
(see rules on reverse side)

CARD MUST BE SIGNED

Starting Date: ..... January 20, 1985  
month day year

API Number 15- 163-22,612-00-00

**OPERATOR:** License # ..... 4131  
Name ..... Fame Oil Operations, Inc.  
Address ..... 318 E. 11th St.  
City/State/Zip ..... Russell, KS 67665  
Contact Person ..... Gary Waggle  
Phone ..... (913)-483-6484

SE SW SE ..... Sec 12 Twp 7 S Rge 20  
(location)  East  West

..... 330 ..... Ft North from Southeast Corner of Section  
..... 1650 ..... Ft West from Southeast Corner of Section  
(Note: Locate well on Section Plat on reverse side)

**CONTRACTOR:** License # ..... 8241  
Name ..... Emphasis Oil Operations  
City/State ..... P. O. Box 506, Russell, KS 67665-0506

Nearest lease or unit boundary line ..... 330 ..... feet.  
County ..... Rooks  
Lease Name ..... Stice ..... Well# 1

**Well Drilled For:**      **Well Class:**      **Type Equipment:**  
 Oil       Swd       Infield       Mud Rotary  
 Gas       Inj       Pool Ext.       Air Rotary  
 OWWO       Expl       Wildcat       Cable

Domestic well within 330 feet :       yes       no  
Municipal well within one mile :       yes       no

If OWWO: old well info as follows:

Operator .....  
Well Name .....  
Comp Date .....      Old Total Depth .....  
Projected Total Depth ..... 3625 ..... feet  
Projected Formation at TD ..... Arbuckle  
Expected Producing Formations ..... Arbuckle

Depth to Bottom of fresh water ..... 75 ..... feet  
Lowest usable water formation ..... Dakota  
Depth to Bottom of usable water ..... 950 ..... feet  
Surface pipe by Alternate :      1       2   
Surface pipe to be set ..... 240 ..... feet  
Conductor pipe if any required ..... feet  
Ground surface elevation ..... 2050 Est. ..... feet MSL  
This Authorization Expires ..... 7-9-85  
Approved By ..... 1-9-85 *R.C.*

I certify that we will comply with K.S.A. 55-101, et seq., plus eventually plugging hole to K.C.C. specifications.

Date 1-8-85 ..... Signature of Operator or Agent

*[Signature]* Title


Agent

MHC/KOHE 1-9-85

**Must be filed with the K.C.C. five (5) days prior to commencing well  
This card void if drilling not started within six (6) months of date received by K.C.C.**

**Important procedures to follow:**

**A Regular Section of Land  
1 Mile = 5,280 Ft.**

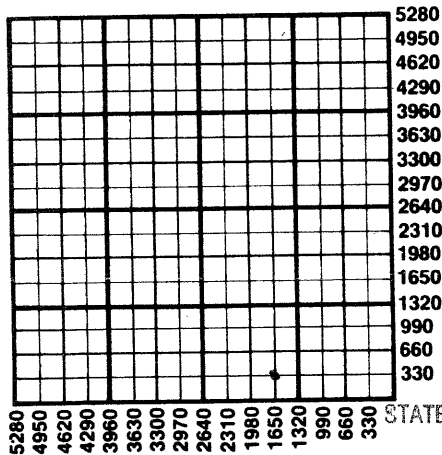

1. Notify District office before setting surface casing.
2. Set surface casing by circulating cement to the top.
3. File completion forms ACO-1 with K.C.C. within 90 days of well completion, following instructions on ACO-1, side 1, and including copies of wireline logs.
4. Notify District office 48 hours prior to old well workover or re-entry.
5. Prior to plugging, prepare a plugging plan, then obtain agreement from the appropriate district office for an approved plugging plan.
6. Submit plugging report (CP-4) to K.C.C. after plugging is completed.
7. Obtain an approved injection docket number before disposing of salt water.
8. Notify K.C.C. within 10 days when injection commences or terminates.
9. If an alternate 2 completion, cement in the production pipe from below any usable water to surface within 120 days of spud date.

RECEIVED  
STATE CORPORATION COMMISSION

01-09-1985  
JAN 09 1985

CONSERVATION DIVISION  
Wichita, Kansas

State Corporation Commission of Kansas  
Conservation Division  
200 Colorado Derby Building  
Wichita, Kansas 67202  
(316) 263-3238