

CARD MUST BE TYPED

State of Kansas

CARD MUST BE SIGNED

NOTICE OF INTENTION TO DRILL

(see rules on reverse side)

Starting Date 9 2 86
month day year

API Number 15— 163-22,888-00-00

OPERATOR: License # 4985

app. NE SW NW Sec. 10 Twp. 7 S, Rg. 20 East

Name Ja Bon Investments

Address Box 28

City/State/Zip Zurich, Kansas 67676

Contact Person Glen L. Lambert

Phone 913-737-2146

3530 Ft. from South Line of Section

4080 Ft. from East Line of Section

(Note: Locate well on Section Plat on reverse side)

Nearest lease or unit boundary line 440 feet

County Rooks

Lease Name Probasco Well # 1

Ground surface elevation 2080 feet MSL

Domestic well within 330 feet: yes no

Municipal well within one mile: yes no

Depth to bottom of fresh water 100 feet

Depth to bottom of usable water 1000 feet

Surface pipe by Alternate: 1 2

Surface pipe planned to be set 250

Conductor pipe required

Projected Total Depth 3700 feet

Formation Arbuckle

Well Drilled For: Well Class: Type Equipment:
 Oil SWD Infield Mud Rotary
 Gas Inj Pool Ext. Air Rotary
 OWWO Expl Wildcat Cable

If OWWO: old well info as follows:

Operator

Well Name

Comp Date Old Total Depth

I certify that well will comply with K.S.A. 55-101, et seq., plus eventually plugging hole to KCC specifications.

Date 8/28/86 Signature of Operator or Agent Glen L. Lambert Title as agent

For KCC Use:

Conductor Pipe Required feet; Minimum Surface Pipe Required 250 feet per Alt. ②


This Authorization Expires 2-28-87 Approved By Glen L. Lambert

Must be filed with the K.C.C. five (5) days prior to commencing well
 This card void if drilling not started within six (6) months of date received by K.C.C.

Important procedures to follow:

1. Notify District office before setting surface casing.
2. Set surface casing by circulating cement to the top.
3. File completion forms ACO-1 with K.C.C. within 90 days of well completion, following instructions on ACO-1, side 1, and including copies of wireline logs.
4. Notify District office 48 hours prior to old well workover or re-entry.
5. Prior to filing Intent, prepare a proposed plugging plan in case well is D & A, then obtain approval of plan when calling district office prior to setting surface pipe.
6. Submit plugging report (CP-4) to K. C. C. after plugging is completed.
7. Obtain an approved injection docket number before disposing of salt water.
8. Notify K.C.C. within 10 days when injection commences or terminates.
9. If an alternate 2 completion, cement in the production pipe from below any usable water to surface within 120 days of spud date.

**A Regular Section of Land
 1 Mile = 5,280 Ft.**

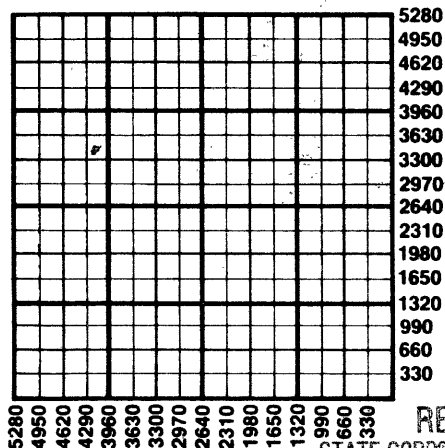

RECEIVED
 STATE CORPORATION COMMISSION
 08-28-1986
 AUG 28 1986

CONSERVATION DIVISION
 Wichita, Kansas

State Corporation Commission of Kansas
 Conservation Division
 200 Colorado Derby Building
 Wichita, Kansas 67202
 (316) 263-3238