

CARD MUST BE TYPED

State of Kansas
NOTICE OF INTENTION TO DRILL
(see rules on reverse side)

CARD MUST BE SIGNED

Starting Date: 10/15/84
month day year

API Number 15- 163-22,512-00-00

OPERATOR: License # 5131
Name Thunderbird Drilling, Inc.
Address P.O. Box 18407
City/State/Zip Wichita, Ks. 67218
Contact Person Burke Krueger
Phone (316) 685-1441

.. NW NW NE Sec 10 Twp 7 S, Rge 20 ..
(location) East West

CONTRACTOR: License # 5131
Name Thunderbird Drilling, Inc.
City/State same as above

4950 Ft North from Southeast Corner of Section
2310 Ft West from Southeast Corner of Section
(Note: Locate well on Section Plat on reverse side)

Nearest lease or unit boundary line 2310 feet.
County Rooks
Lease Name TIMMONS Well # 1

Well Drilled For: Well Class: Type Equipment:
 Oil Swd Infield Mud Rotary
 Gas Inj Pool Ext. Air Rotary
 OWWO Expl Wildcat Cable

Domestic well within 330 feet: yes no
Municipal well within one mile: yes no

If OWWO: old well info as follows:

Operator
Well Name
Comp Date Old Total Depth
Projected Total Depth 3650 feet
Projected Formation at TD Arb
Expected Producing Formations LKC-Arb

Depth to Bottom of fresh water 160 feet
Lowest usable water formation Dakota
Depth to Bottom of usable water 1000 feet
Surface pipe by Alternate: 1 2
Surface pipe to be set 320 feet
Conductor pipe if any required none feet
Ground surface elevation 2150 feet MSL
This Authorization Expires 4-4-85
Approved By 10-4-84 R.

I certify that we will comply with K.S.A. 55-101, et seq., plus eventually plugging hole to K.C.C. specifications.

Date 10/1/84 Signature of Operator or Agent Gloria DeJesus Title Land Mgr.

SGA/KDHF
10/4/84
Form C-1 4/84


Must be filed with the K.C.C. five (5) days prior to commencing well
 This card void if drilling not started within six (6) months of date received by K.C.C.

10-~~10~~-1984

RECEIVED
 STATE CORPORATION COMMISSION
 OCT 04 1984
 Wichita, Kansas

Important procedures to follow:

A Regular Section of Land
1 Mile = 5,280 Ft.

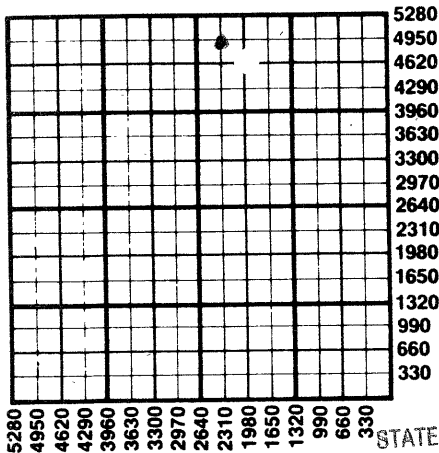

1. Notify District office before setting surface casing.
2. Set surface casing by circulating cement to the top.
3. File completion forms ACO-1 with K.C.C. within 90 days of well completion, following instructions on ACO-1, side 1, and including copies of wireline logs.
4. Notify District office 48 hours prior to old well workover or re-entry.
5. Prior to plugging, prepare a plugging plan, then obtain agreement from the appropriate district office for an approved plugging plan.
6. Submit plugging report (CP-4) to K.C.C. after plugging is completed.
7. Obtain an approved injection docket number before disposing of salt water.
8. Notify K.C.C. within 10 days when injection commences or terminates.
9. If an alternate 2 completion, cement in the production pipe from below any usable water to surface within 120 days of spud date.

RECEIVED
 STATE CORPORATION COMMISSION

State Corporation Commission of Kansas
 Conservation Division
 200 Colorado Derby Building
 Wichita, Kansas 67202
 (316) 263-3238

OCT 02 1984

CONSERVATION DIVISION
 Wichita, Kansas