

CORRECTED

RECEIVED

KANSAS CORPORATION COMMISSION

For KCC Use: 11-19-05  
Effective Date: 2  
District #: 2  
SGA? ☐ Yes ☒ No

KANSAS CORPORATION COMMISSION  
OIL & GAS CONSERVATION DIVISION

NOV 2 2005

Form C-1  
December 2002

NOTICE OF INTENT TO DRILL

Must be approved by the K.C.C. five (5) days prior to commencing well

CONSERVATION DIVISION  
WICHITA, KS

Form must be Signed  
All blanks must be Filled

Expected Spud Date JANUARY 2 2006  
month day year

OPERATOR: License # 3882  
Name: SAMUEL GARY JR. & ASSOCIATES, INC.  
Address: 1670 BROADWAY, SUITE 3300  
City/State/Zip: DENVER, CO 80202  
Contact Person: TOM FERTAL  
Phone: (303) 831-4673

CONTRACTOR: License 33323  
Name: PETROMARK DRILLING

Well Drilled For: ☒ Oil ☐ Enh Rec ☐ Gas ☐ Storage ☐ OWWO ☐ Disposal ☐ Seismic; # of Holes ☐ Other  
Well Class: ☐ Infield ☒ Pool Ext. ☐ Wildcat ☐ Other  
Type Equipment: ☒ Mud Rotary ☐ Air Rotary ☐ Cable

If OWWO: old well information as follows:  
Operator:  
Well Name:  
Original Completion Date: Original Total Depth:

Directional, Deviated or Horizontal wellbore? ☐ Yes ☒ No  
If yes, true vertical depth:  
Bottom Hole Location:  
KCC DKT#:

Spot 60' N & 200' W OF CENTER  
S/2 - S/2 - NE Sec. 34 Twp. 17 S. R. 10  
2250 feet from ☒ N / ☐ S Line of Section  
1520 feet from ☒ E / ☐ W Line of Section  
Is SECTION X Regular Irregular?  
(Note: Locate well on the Section Plat on Reverse Side)

County: ELLSWORTH  
Lease Name: SCHROEDER-MAES Well #: 10-34  
Field Name:  
Is this a Prorated / Spaced Field? ☐ Yes ☒ No  
Target Formation(s): ARBUCKLE  
Nearest Lease or unit boundary: 390'  
Ground Surface Elevation: EST 1303' feet MSL  
Water well within one-quarter mile: ☐ Yes ☒ No  
Public water supply well within one mile: ☐ Yes ☒ No  
Depth to bottom of fresh water: 180'  
Depth to bottom of usable water: 400'  
Surface Pipe by Alternate: ☒ 1 ☐ 2  
Length of Surface Pipe Planned to be set: 420'  
Length of Conductor pipe required: NONE  
Projected Total Depth: 3500'  
Formation at Total Depth: ARBUCKLE  
Water Source for Drilling Operations:  
☐ Well ☐ Farm Pond Other X  
DWR Permit #: N/A  
(Note: Apply for Permit with DWR ☐)  
Will Cores Be Taken? ☐ Yes ☒ No  
If yes, proposed zone: N/A

Correction: location was 1400' FEL

AFFIDAVIT

it is 1520' FEL

RECEIVED  
KANSAS CORPORATION COMMISSION

NOV 14 2005

CONSERVATION DIVISION  
WICHITA, KS

The undersigned hereby affirms that the drilling, completion and eventual plugging of this well will comply with K.S.A. 55-101, et. seq.  
It is agreed that the following minimum requirements will be met:

1. Notify the appropriate district office prior to spudding of well;
2. A copy of the approved Notice of Intent to Drill shall be posted on each drilling rig;
3. The minimum amount of surface pipe as specified below shall be set by circulating cement to the top; in all cases surface pipe shall be set through all unconsolidated materials plus a minimum of 20 feet into the underlying formation;
4. If the well is a dry hole, an agreement between the operator and the district office on plug length and placement is necessary prior to plugging;
5. The appropriate district office will be notified before well is either plugged or production casing is cemented in;
6. If an ALTERNATE II COMPLETION, production pipe shall be cemented from below any usable water to surface within 120 days of spud date.  
Or pursuant to Appendix "B" - Eastern Kansas surface casing order #133,891-C, which applies to the KCC District 3 area, alternate II cementing must be completed within 30 days of spud date or the well shall be plugged. In all cases, NOTIFY district office prior to any cementing.

I hereby certify that the statements made herein are true and to the best of my knowledge and belief.

Date: November 11, 2005 Signature of Operator or Agent: Thomas Fertal Title: SR. GEOLOGIST

For KCC use ONLY  
API # 15 - 053-21169-00-00  
Conductor pipe required NONE feet  
Minimum surface pipe required 420 feet per Alt. 1  
Approved by: 11-14-05/123012605  
This authorization expires: 5-14-06  
(This authorization void if drilling not started within 6 months of effective date.)  
Spud date: Agent:

Remember to:

- File Drill Pit Application (Form CDP-1) with Intent to Drill;
- File Completion Form ACO-1 within 120 days of spud date;
- File acreage attribution plat according to field proration orders;
- Notify appropriate district office 48 hours prior to workover or re-entry;
- Submit plugging report (CP-4) after plugging is completed;
- Obtain written approval before disposing or injecting salt water.
- If this permit has expired (See: authorized expiration date) please check the box below and return to the address below.  
☐ Well Not Drilled - Permit Expired  
Signature of Operator or Agent:  
Date:

Mail to: KCC - Conservation Division 130 S. Market - Room 2078, Wichita, Kansas 67202

34 17 102

NOV 23 2005

CONSERVATION DIVISION  
WICHITA, KS

Side Two

**IN ALL CASES PLOT THE INTENDED WELL ON THE PLAT BELOW**

*Plat of Acreage attributable to a well in a prorated or spaced field*

**If the intended well is in a prorated or spaced field, please fully complete this side of the form.** If the intended well is in a prorated or spaced field complete the plat below showing that the well will be properly located in relationship to other wells producing from the common source of supply. Please show all the wells and within 1 mile of the boundaries of the proposed acreage attribution unit for gas wells and within 1/2 mile of the boundaries of the proposed acreage attribution unit for oil wells.

API No. 15 - \_\_\_\_\_

Operator: SAMUEL GARY JR & ASSOCIATES, INC.

Lease: SCHROEDER-MAES

Well Number: 10-34

Field: \_\_\_\_\_

Number of Acres attributable to well: \_\_\_\_\_

QTR / QTR / QTR of acreage: \_\_\_\_\_ - \_\_\_\_\_ - \_\_\_\_\_

Location of Well: County: ELLSWORTH

2250 feet from ☒ N / ☐ S Line of Section

☒ 1520 feet from ☒ E / ☐ W Line of Section

Sec. 34 Twp. 17 S. R. 10 ☐ East ☒ West

Is Section: ☒ Regular or ☐ Irregular



**If Section is Irregular, locate well from nearest corner boundary.**

Section corner used: ☐ NE ☐ NW ☐ SE ☐ SW

**PLAT**

(Show location of the well and shade attributable acreage for prorated or spaced wells.)

(Show footage to the nearest lease or unit boundary line.)

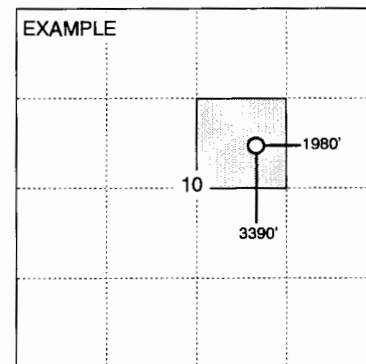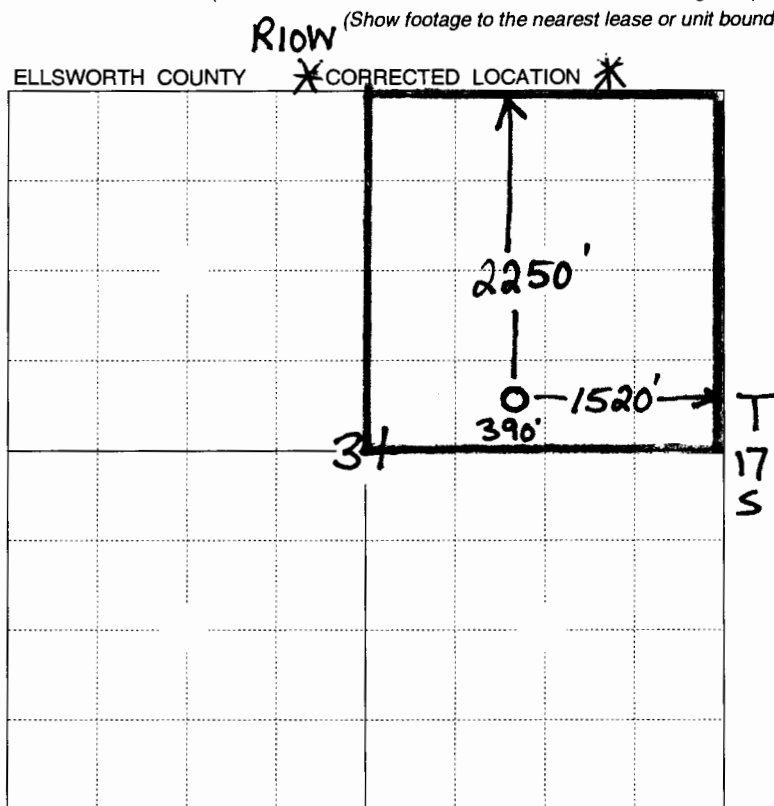

SEWARD CO.

**CORRECTED**

**NOTE: In all cases locate the spot of the proposed drilling location.**

**In plotting the proposed location of the well, you must show:**

1. The manner in which you are using the depicted plat by identifying section lines, i.e. 1 section, 1 section with 8 surrounding sections, 4 sections, etc.
2. The distance of the proposed drilling location from the section's south / north and east / west.
3. The distance to the nearest lease or unit boundary line.
4. If proposed location is located within a prorated or spaced field a certificate of acreage attribution plat must be attached: (CO-7 for oil wells; CG-8 for gas wells).