

RECEIVED

NOV 28 2005

KCC WICHITA

Form C-1  
December 2002  
Form must be Typed  
Form must be Signed  
Form must be Filled

For KCC Use:  
Effective Date: 11-15-05  
District #: 4  
SGA?  Yes  No

KANSAS CORPORATION COMMISSION  
OIL & GAS CONSERVATION DIVISION  
**NOTICE OF INTENT TO DRILL**

Must be approved by KCC five (5) days prior to commencing well

Expected Spud Date 12/01/05  
month day year

OPERATOR: License# 33116  
Name: Berry Petroleum Company  
Address: P. O. Box 250  
Wray, Co 80758  
City/State/Zip:  
Contact Person: Loni Davis  
Phone: 970-332-3585  
CONTRACTOR: License# 8273  
Name: Excell Services, Inc.

**CORRECTE**

Spot \_\_\_\_\_  East  
NWNE NE SW Sec. 19 Twp. 6 S. R. 39  West  
2587.8' feet from  N /  S Line of Section  
2217.7' feet from  E /  W Line of Section  
Is SECTION  Regular  Irregular?

(Note: Locate well on the Section Plat on reverse side)

County: Sherman  
Lease Name: Bratcher Well #: 23-19 6S39W  
Field Name: Wildcat

Is this a Prorated / Spaced Field?  Yes  No  
Target Formation(s): Niobrara

Nearest Lease or unit boundary: 2217.7'  
Ground Surface Elevation: 3574' feet MSL

Water well within one-quarter mile:  Yes  No  
Public water supply well within one mile:  Yes  No

Depth to bottom of fresh water: 300'  
Depth to bottom of usable water: 300'

Surface Pipe by Alternate:  1  2  
Length of Surface Pipe Planned to be set: 400' min

Length of Conductor Pipe required: None  
Projected Total Depth: 1550

Formation at Total Depth: Smokey Hill - Niobrara  
Water Source for Drilling Operations:

Well  Farm Pond Other City of Goodland  
DWR Permit #: N/A

(Note: Apply for Permit with DWR )

Will Cores be taken?  Yes  No  
If Yes, proposed zone: \_\_\_\_\_

Well Drilled For: Well Class: Type Equipment:  
 Oil  Enh Rec  Infield  Mud Rotary  
 Gas  Storage  Pool Ext.  Air Rotary  
 OWWO  Disposal  Wildcat  Cable  
 Seismic; # of Holes  Other  
 Other

If OWWO: old well information as follows:  
Operator: \_\_\_\_\_  
Well Name: \_\_\_\_\_  
Original Completion Date: \_\_\_\_\_ Original Total Depth: \_\_\_\_\_

Directional, Deviated or Horizontal wellbore?  Yes  No  
If Yes, true vertical depth: \_\_\_\_\_  
Bottom Hole Location: \_\_\_\_\_  
KCC DKT #: \_\_\_\_\_

\* WAS: 2587' FSL, 2090 FWL,  
IS: 2587' FSL, 2217' FWL,

**AFFIDAVIT**

\*unit info received

The undersigned hereby affirms that the drilling, completion and eventual plugging of this well will comply with K.S.A. 55 et. seq.

It is agreed that the following minimum requirements will be met:

1. Notify the appropriate district office **prior** to spudding of well;
2. A copy of the approved notice of intent to drill **shall be** posted on each drilling rig;
3. The minimum amount of surface pipe as specified below **shall be set** by circulating cement to the top; in all cases surface pipe **shall be set** through all unconsolidated materials plus a minimum of 20 feet into the underlying formation.
4. If the well is dry hole, an agreement between the operator and the district office on plug length and placement is necessary **prior to plugging**;
5. The appropriate district office will be notified before well is either plugged or production casing is cemented in;
6. If an ALTERNATE II COMPLETION, production pipe shall be cemented from below any usable water to surface within **120 days** of spud date. Or pursuant to Appendix "B" - Eastern Kansas surface casing order #133,891-C, which applies to the KCC District 3 area, alternate II cementing must be completed within 30 days of the spud date or the well shall be plugged. **In all cases, NOTIFY district office** prior to any cementing.

I hereby certify that the statements made herein are true and to the best of my knowledge and belief.

Date: 11/21/05 Signature of Operator or Agent: Loni Davis Title: Operations Accounting and Regulatory

**For KCC Use ONLY**  
API # 15 - 181-20394-00-06  
Conductor pipe required NONE feet  
Minimum surface pipe required 3SP feet per Alt. (1)  
Approved by: RJP 11-10-05 / RJP 12-9-05  
This authorization expires: 5-10-06  
(This authorization void if drilling not started within 6 months of effective date.)  
Spud date: \_\_\_\_\_ Agent: \_\_\_\_\_

**Remember to:**

- File Drill Pit Application (form CDP-1) with Intent to Drill;
- File Completion Form ACO-1 within 120 days of spud date;
- File acreage attribution plat according to field proration orders;
- Notify appropriate district office 48 hours prior to workover or re-entry;
- Submit plugging report (CP-4) after plugging is completed;
- Obtain written approval before disposing or injecting salt water.

- If this permit has expired (See: authorized expiration date) please check the box below and return to the address below.

Well Not Drilled - Permit Expired

Signature of Operator or Agent: \_\_\_\_\_  
Date: \_\_\_\_\_

19  
6  
392

IN ALL CASES PLOT THE INTENDED WELL ON THE PLAT BELOW

Plat of acreage attributable to a well in a prorated or spaced field

If the intended well is in a prorated or spaced field, please fully complete this side of the form. If the intended well is in a prorated or spaced field complete the plat below showing that the well will be properly located in relationship to other wells producing from the common source of supply. Please show all the wells and within 1 mile of the boundaries of the proposed acreage attribution unit for gas wells and within 1/2 mile of the boundaries of the proposed acreage attribution unit for oil wells.

API No. 15 - \_\_\_\_\_
Operator: Berry Petroleum Company
Lease: Bratcher
Well Number: 23-19 6S39W
Field: Wildcat

Location of Well: County: Sherman
2587.8' feet from [ ] N / [x] S Line of Section
2217.7' feet from [ ] E / [x] W Line of Section
Sec. 19 Twp. 6 S. R. 39 [ ] East [x] West

Number of Acres attributable to well: 10
QTR / QTR / QTR of acreage: NE - NE - SW


Is Section: [x] Regular or [ ] Irregular

If Section is Irregular, locate well from nearest corner boundary.


Section corner used: [ ] NE [ ] NW [ ] SE [ ] SW

PLAT

(Show location of the well and shade attributable acreage for prorated or spaced wells.)
(Show footage to the nearest lease or unit boundary line.)

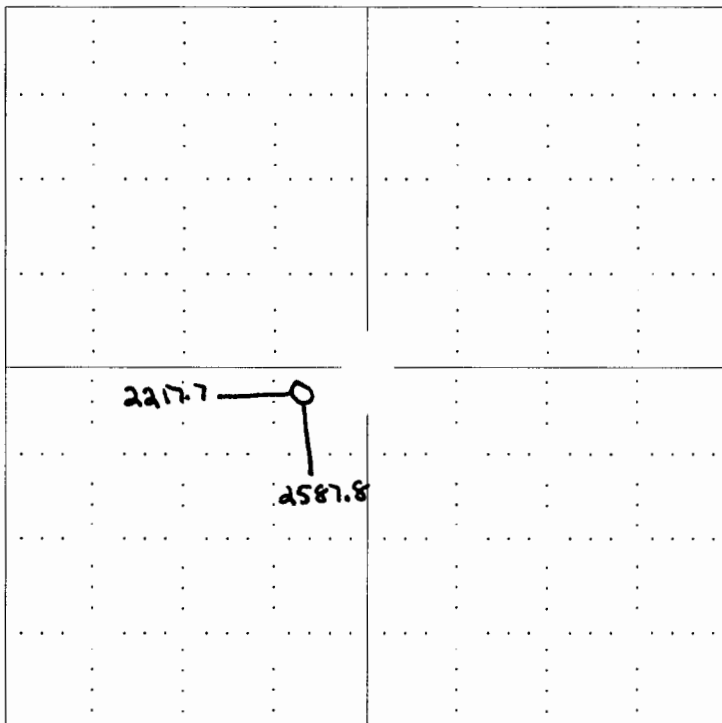

CORRECTED

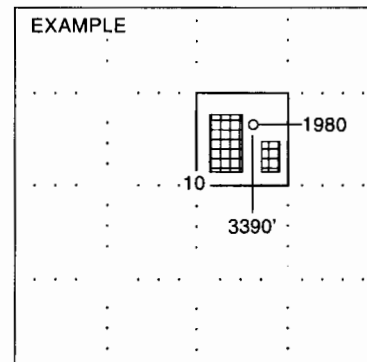

SEWARD CO.

NOTE: In all cases locate the spot of the proposed drilling location.

In plotting the proposed location of the well, you must show:

- 1. The manner in which you are using the depicted plat by identifying section lines, i.e. 1 section, 1 section with 8 surrounding sections, 4 sections, etc.
2. The distance of the proposed drilling location from the section's south / north and east / west.
3. The distance to the nearest lease or unit boundary line.
4. If proposed location is located within a prorated or spaced field a certificate of acreage attribution plat must be attached: (CO-7 for oil wells; CG-8 for gas wells).