

COPY


WELL LOG BUREAU—KANSAS GEOLOGICAL SOCIETY
508 East Murdock, Wichita, Kansas

15-163-30035-00-00

Company R. W. Rine Drilling
Farm Riffe No. 1

SEC. 1 T. 7 R. 20W
NW NW NW

Total Depth 3750'
Comm. 6-1-65 Comp. 6-9-65
Shot or Treated.
Contractor Graves Drig.
Issued 9-25-65

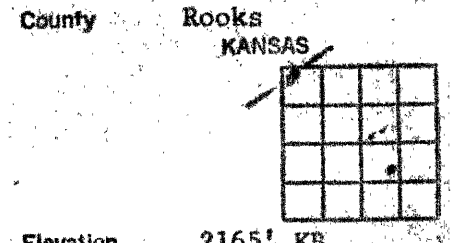

Elevation 2165' KB

Production DRY

8 5/8" 211' cem w/ 150 sx
5 1/2" 3640' cem w/ 250 sx Figures Indicate Bottom of Formations.

sod & clay	30
sand	65
shale & clay	105
shale, clay & lime	210
shale	735
sand	785
shale	1140
lime & shale	1240
sand	1440
shale	1490
shale & shells	1725
lime	1885
shale & lime	3010
lime & shale	3153
lime	3571
lime & shale	3600
lime	3663
lime & shale	3724
sand	3738
granite	3750 RTD
Total Depth	

TOPS :SMP	
Topeka	3154
Reebner	3354
Toronto	3377
Lansing	3392
Base Kansas City	3576
Arbuckle	3635
Reagan	3729

RECEIVED
STATE CORPORATION COMMISSION
OCT 31 1966
OCT 31 1966
CONSERVATION DIVISION
Wichita, Kansas