

CARD MUST BE TYPED

State of Kansas

CARD MUST BE SIGNED

NOTICE OF INTENTION TO DRILL

(see rules on reverse side)

CORRECTED

*

Starting Date January 26, 1988
month day year

API Number 15— 163-22,979-00-00
Approx.

OPERATOR: License # 5663

C/NE... SW Sec. 27 Twp. 7 S, Rg. 18 East West

Name Hess Oil Company

* 1955 Ft. from South Line of Section

Address Box 905

* 3275 Ft. from East Line of Section

City/State/Zip McPherson, KS 67460

(Note: Locate well on Section Plat on reverse side)

Contact Person Jamie Hess

Nearest lease or unit boundary line 660 feet

Phone (316) 263-2243

County Rooks

CONTRACTOR: License # 4958

Lease Name Kollman Well # 1

Name Mallard J.V., Inc.

* Ground surface elevation 1900 1815 TOP feet MSL

City/State McPherson, KS 67460

Domestic well within 330 feet: —yes Xno

Well Drilled For: Well Class: Type Equipment:

Municipal well within one mile: —yes Xno

Oil SWD Infield Mud Rotary

Depth to bottom of fresh water 200'

Gas Inj Pool Ext. Air Rotary

Depth to bottom of usable water 800'

OWWO Expl Wildcat Cable

Surface pipe by Alternate: 1 X 2 X

If OWWO: old well info as follows:

* Surface pipe planned to be set 1270'

Operator

* Conductor pipe required 54'

Well Name

Projected Total Depth 3400 feet

Comp Date Old Total Depth

Formation Arbuckle

I certify that well will comply with K.S.A. 55-101, et seq., plus eventually plugging hole to KCC specifications.

Date 1-26-88 Signature of Operator or Agent

Bryan Hess Title Mgr.

For KCC Use: Conductor Pipe Required 50 feet; Minimum Surface Pipe Required 1270 feet per Alt. 1 X

This Authorization Expires 7-4-88 Approved By Jan 2-3-88


* WAS: 1980' FSL Elevation 1900', Surface Pipe 280', No conductor ORIB RCD 1-4-88
3300 FEL

Must be filed with the K.C.C. five (5) days prior to commencing well
 This card void if drilling not started within six (6) months of date received by K.C.C.

Important procedures to follow:

1. Notify District office before setting surface casing.
2. Set surface casing by circulating cement to the top.
3. File completion forms ACO-1 with K.C.C. within 90 days of well completion, following instructions on ACO-1, side 1, and including copies of wireline logs.
4. Notify District office 48 hours prior to old well workover or re-entry.
5. Prior to filing Intent, prepare a proposed plugging plan in case well is D & A, then obtain approval of plan when calling district office prior to setting surface pipe.
6. Submit plugging report (CP-4) to K. C. C. after plugging is completed.
7. Obtain an approved injection docket number before disposing of salt water.

A Regular Section of Land
1 Mile = 5,280 Ft.

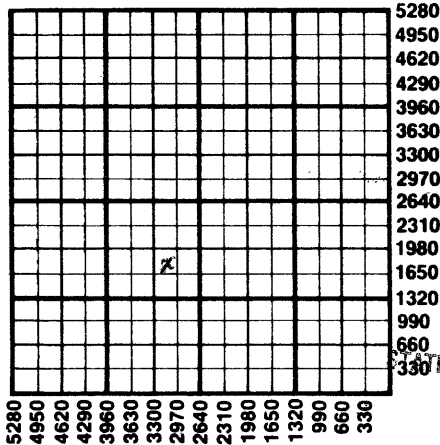

RECEIVED
 STATE CORPORATION COMMISSION

100 03 1988

CONSERVATION DIVISION
 Wichita, Kansas

2-3-88

8. Notify K.C.C. within 10 days when injection commences or terminates.
9. If an alternate 2 completion, cement in the production pipe from below any usable water to surface within 120 days of spud date.

State Corporation Commission of Kansas
 Conservation Division
 200 Colorado Derby Building
 Wichita, Kansas 67202
 (316) 263-3238