

15-163-20474-00-00

STATE OF KANSAS
STATE CORPORATION COMMISSION

Form CP-4


WELL PLUGGING RECORD

Give All Information Completely
Make Required Affidavit
Mail or Deliver Report to:
Conservation Division
State Corporation Commission
P. O. Box 17027
Wichita, Kansas 67217
NORTH

Rooks

County. Sec. 8 Twp. 7S Rge. 20W (E) (W)X

Location as "NE/CNW/SW" or footage from lines SW NE NW
Lease Owner Clinton Oil Company
Lease Name Cecil Roy Well No. No. 1-V
Office Address 217 North Water, Wichita, Kansas 67202
Character of Well (completed as Oil, Gas or Dry Hole) D & A
Date well completed March 29 19 73
Application for plugging filed March 29 19 73
Application for plugging approved March 29 19 73
Plugging commenced March 29 19 73
Plugging completed March 29 19 73
Reason for abandonment of well or producing formation D & A

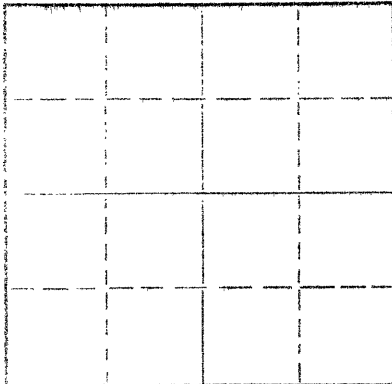

Locate well correctly on above
Section Plat

If a producing well is abandoned, date of last production 19
Was permission obtained from the Conservation Division or its agents before plugging was commenced? Yes

Name of Conservation Agent who supervised plugging of this well Leo F. Massey
Producing formation Depth to top Bottom Total Depth of Well 3715 Feet
Show depth and thickness of all water, oil and gas formations.

OIL, GAS OR WATER RECORDS

CASING RECORD

FORMATION	CONTENT	FROM	TO	SIZE	PUT IN	PULLED OUT
				10-3/4"	233'	-0-

Describe in detail the manner in which the well was plugged, indicating where the mud fluid was placed and the method or methods used in introducing it into the hole. If cement or other plugs were used, state the character of same and depth placed, from feet to feet for each plug set.

Cemented @ 750' w/80 sx
@ 220' w/25 sx
@ 40' w/15 sx & 1/2 sk hulls
(Wooden Plug) Plug Down w/50-50 Pozmix,
6% Total Gel

RECEIVED
STATE CORPORATION COMMISSION
APR 6 1973
04-06-1973
CONSERVATION DIVISION
Wichita, Kansas

(If additional description is necessary, use BACK of this sheet)
Name of Plugging Contractor Red Tiger Drilling Company
Address 1720 Wichita Plaza, Wichita, Kansas 67202

STATE OF Kansas COUNTY OF Sedgwick
Linda H. Dickens (employee of owner) or (owner or operator) of the above-described

well, being first duly sworn on oath, says: That I have knowledge of the facts, statements, and matters herein contained and the log of the above-described well as filed and that the same are true and correct. So help me God.

(Signature) Linda H. Dickens
1720 Wichita Plaza, Wichita, Kansas 67202
(Address)

SWORN to before me this 2nd day of April, 1973



October 25, 1976
Gloria Inwett
Notary Public.

15-163-20474-00-00

DRILLERS LOG

No. 1-V Cecil Roy

CASING RECORD:

10 3/4" @ 232.78'
w/200 sx cement

TOTAL DEPTH: 3715'

COMPANY: Clinton Oil Co.

CONTRACTOR: Red Tiger Drilling Co.

COMMENCED: March 21, 1973

COMPLETED: March 29, 1973

DESCRIPTION:

SW NE NW
8-7S-20W
Rooks County,
Kansas

ELEVATION:

<u>FORMATION</u>	<u>FROM</u>	<u>TO</u>	<u>REMARKS</u>
Sand, Clay & Shale	0	234	
Shale	234	1140	
Shale & Sand	1140	1310	
Sand	1310	1508	
Shale	1508	1756	
Anhydrite	1756	1780	
Shale	1780	1810	
Shale, Redbed & Lime Streaks	1810	2385	
Lime & Shale	2385	3258	
Lime	3258	3715	

RECEIVED
STATE CORPORATION COMMISSION
APR 6 1973
CONSERVATION DIVISION
Wichita, Kansas

I certify that this is a true and correct copy of the above log to the best of my knowledge.

RED TIGER DRILLING COMPANY

Gloria Fawcett
Gloria Fawcett

Subscribed and sworn to before me this 2nd day of April, 1973.

Linda H. Dickens
Notary Public

My Commission Expires:

March 8, 1977

