

15-103-30014-00-00

STATE OF KANSAS
STATE CORPORATION COMMISSION

WELL PLUGGING RECORD

Give All Information Completely
Make Required Affidavit
Mail or Deliver Report to:
Conservation Division
State Corporation Commission
211 No. Broadway
Wichita, Kansas

Rooks County. Sec. 6 Twp. 7 Rge. 19 (E) W (W)

Location as "NE/CNW/SW" or footage from lines SW/SW/NE

Lease Owner John Ostmeyer

Lease Name Smith Well No. 1

Office Address Leo J. Dreiling Oil Co. Victoria, Ks.

Character of Well (completed as Oil, Gas or Dry Hole) Dry hole.

Date well completed _____ 19____

Application for plugging filed Mar. 30, 19 65

Application for plugging approved Apr. 3, 19 65


Plugging commenced Apr. 4, 19 65

Plugging completed Apr. 6, 19 65

Reason for abandonment of well or producing formation Dry Hole.

If a producing well is abandoned, date of last production _____ 19____

Was permission obtained from the Conservation Division or its agents before plugging was commenced? Yes

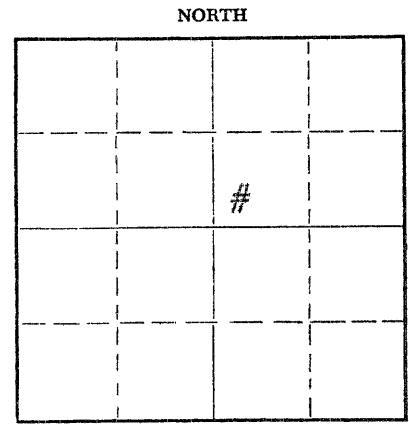

Name of Conservation Agent who supervised plugging of this well Eldon Petty

Producing formation _____ Depth to top _____ Bottom _____ Total Depth of Well 3567' Feet

Show depth and thickness of all water, oil and gas formations.

OIL, GAS OR WATER RECORDS

CASING RECORD

FORMATION	CONTENT	FROM	TO	SIZE	PUT IN	PULLED OUT
				8 5/8	155'	None
				5 1/2	3558'	2707'

Describe in detail the manner in which the well was plugged, indicating where the mud fluid was placed and the method or methods used in introducing it into the hole. If cement or other plugs were used, state the character of same and depth placed, from _____ feet to _____ feet for each plug set.

Plugged back with sand from 3522' to 3280'. Mixed and dumped 4 sx. of cement from 3280' to 3248' with dump bailer. Pulled casing to 600'. Mixed and circulated 15 sx. of gel mud. Mixed and pumped in 20sx. of cement from 600' to 540'. Pulled casing to 210'. Mixed and pumped in 20 sx. of cement from 210' to 150'. Pulled rest of the casing. Bailed off gel to 40'. Set 10' rock bridge from 40' to 30'. Mixed and dumped 10 sx. of cement from 30' to base of the cellar.

RECEIVED
STATE CORPORATION COMMISSION

APR 15 1965

CONSERVATION DIVISION
Wichita, Kansas

4-15-65

(If additional description is necessary, use BACK of this sheet)

Name of Plugging Contractor Ace Pipe Pulling Co.

Address Box 304 Great Bend, Ks.

STATE OF Kansas, COUNTY OF Ellis, ss. I, Leo F. Dreiling

(employee of owner) or (owner/operator) of the above-described well, being first duly sworn on oath, says: That I have knowledge of the facts, statements, and matters herein contained and the log of the above-described well as filed and that the same are true and correct. So help me God.

(Signature) Leo F. Dreiling
Victoria, Kansas (Address)

SUBSCRIBED AND SWORN TO before me this 13 day of April, 19 65

My commission expires October 26, 1965

Elmer Weltz
Elmer Weltz Notary Public.

15-163-30014-00-00

L. J. DREILING and SONS, Inc.

VICTORIA, KANSAS

WELL LOG

Company John Ostemeyer
Orinell, Kansas

Sec. 6 Twp. 7 Rng. 19

Farm Smith No. # 1

Location SW / SW / NE

Total Depth 3567

County Rocks

Comm. 3-1-67 Comp. 3-11-65

Elevation: 2070 D. F.

Contractor L.J. Dreiling & Sons, Inc.
Victoria, Kansas

2073 G. R.

Casing Record

Cement Record

Production:

155 ft. 8-5/8"

100 sack cement

Arbuckle

3559' 5 1/2"

150 sacks

Figures Indicate Bottom of Formations

0'
75'
155'
215'
100h
1140'
1351'
1625'
1650'
1655'
2015'
2070'
2314'
2525'
2745'
2924'
3099'
3200'
3207'
3280'
3359'
3410'
3458'
3480'
3511'
3567'

75'
155'
215'
100h'
1140'
1351'
1625'
1650'
1655'
2015'
2070'
2314'
2525'
2745'
2924'
3099'
3200'
3207'
3280'
3359'
3410'
3458'
3480'
3511'
3567'
T.D.

Surface Clay & Sand
Blue Shale
Shale
Sand & Shale
Shale
Sand
Shale & Red Sand
Anhy.
Shale
Shale & Shells
Shale & Lime Streaks
Shale & Lime
Shale & Lime
Shale & Lime
Shale & Lime
Shale & Lime
Lime
Lime
Lime
Lime
Lime
Lime
Lime
Lime

STATE OF KANSAS)
ELLIS COUNTY) ss

RECEIVED
STATE CORPORATION COMMISSION
APR 15 1965
4-15-65
CONSERVATION DIVISION
Wichita, Kansas

L, Leo F. Dreiling, of the L.J. Dreiling & Sons, Inc. upon oath states that the above and foregoing is a true and correct copy from the Daily Drilling Report from your Smith # 1.

Leo F. Dreiling
LEO F. DREILING

Subscribed and sworn to before me this 12th day of March, 1965.

My commission expires: October 26, 1968

Elmer Wertz
NOTARY PUBLIC