

15-163-20300-00-00

WELL PLUGGING RECORD

Give All Information Completely
Make Required Affidavit
Mail or Deliver Report to:
Conservation Division
State Corporation Commission
212 No. Market
Wichita, Kansas

Rooks County, Sec. 6 Twp. 7S Rge. 19 (X) (W)

Location as "NE/CNW/SW" or footage from lines SW NE SE

Lease Owner Murfin Drilling Company

Lease Name O'Reagan Well No. 1

Office Address 617 Union Center, Wichita, Kansas

Character of Well (completed as Oil, Gas or Dry Hole) Dry Hole

Date well completed April 1 19 70

Application for plugging filed April 1 19 70

Application for plugging approved April 1 19 70


Plugging commenced April 1 19 70

Plugging completed April 1 19 70

Reason for abandonment of well or producing formation

If a producing well is abandoned, date of last production 19

Was permission obtained from the Conservation Division or its agents before plugging was commenced? Yes

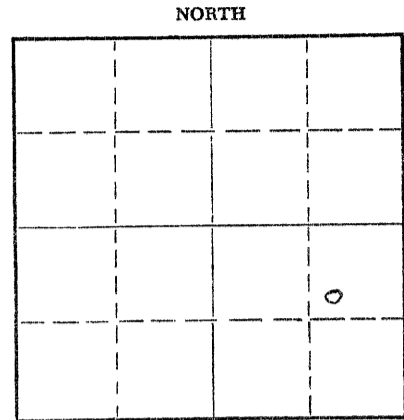

Locate well correctly on above Section Plat

Name of Conservation Agent who supervised plugging of this well Leo Massey

Producing formation Depth to top Bottom Total Depth of Well Feet

Show depth and thickness of all water, oil and gas formations.

OIL, GAS OR WATER RECORDS

CASING RECORD

FORMATION	CONTENT	FROM	TO	SIZE	PUT IN	PULLED OUT
				8 5/8"	195'	

Describe in detail the manner in which the well was plugged, indicating where the mud fluid was placed and the method or methods used in introducing it into the hole. If cement or other plugs were used, state the character of same and depth placed, from feet to feet for each plug set.

1st Plug @ 660' w/70 sacks
2nd Plug @ 180' w/20 sacks
3rd Plug @ 40' w/10 sacks

RECEIVED
STATE CORPORATION COMMISSION
JUN 8 1970
CONSERVATION DIVISION
Wichita, Kansas

6-8-70

(If additional description is necessary, use BACK of this sheet)

Name of Plugging Contractor Murfin Drilling Company
Address 617 Union Center, Wichita, Kansas 67202

STATE OF Kansas COUNTY OF Sedgwick ss.
James R. Daniels (employee of owner) or (owner or operator) of the above-described well, being first duly sworn on oath, says: That I have knowledge of the facts, statements, and matters herein contained and the log of the above-described well as filed and that the same are true and correct. So help me God.

(Signature) James R. Daniels
James R. Daniels
617 Union Center, Wichita, Kansas
(Address)

Subscribed and sworn to before me this 15th day of April 19 70
February 7, 1971
Wilma V. Brokes Notary Public.

