

15-163-20421-00-00

STATE OF KANSAS
STATE CORPORATION COMMISSION

Form CP-4

Give All Information Completely
Make Required Affidavit
Mail or Deliver Report to:
Conservation Division
State Corporation Commission
212 No. Market
Wichita, Kansas 67202

WELL PLUGGING RECORD

Rooks County, Sec. 36 Twp. 7S Rge. 18W (E) (W)

Location as "NE/CNW&SW¼" or footage from lines. NE NE SE

Lease Owner Alpine Drilling Co., Inc.

Lease Name Albright Well No. 1

Office Address 800 Bitting Building, Wichita, Kansas 67202

Character of Well (completed as Oil, Gas or Dry Hole) Dry Hole

Date well completed March 7, 1972 19

Application for plugging filed March 7, 1972 (by phone) 19

Application for plugging approved March 7, 1972 (by phone) 19


Plugging commenced March 7, 1972 19

Plugging completed March 7, 1972 19

Reason for abandonment of well or producing formation

If a producing well is abandoned, date of last production 19

Was permission obtained from the Conservation Division or its agents before plugging was commenced? Yes

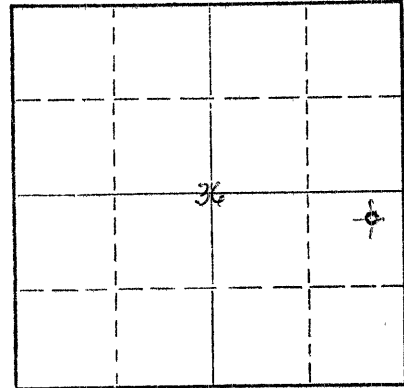

Locate well correctly on above Section Plat

Name of Conservation Agent who supervised plugging of this well Leo F. Massey

Producing formation Depth to top Bottom Total Depth of Well 3446 Feet

Show depth and thickness of all water, oil and gas formations.

OIL, GAS OR WATER RECORDS

CASING RECORD

FORMATION	CONTENT	FROM	TO	SIZE	PUT IN	PULLED OUT
				8-5/8	211	Cemented

Describe in detail the manner in which the well was plugged, indicating where the mud fluid was placed and the method or methods used in introducing it into the hole. If cement or other plugs were used, state the character of same and depth placed, from feet to feet for each plug set.

Plug and 70 sacks of cement at 600 feet; 20 sacks at 210 feet; plug and 1/2 sack hulls at 408 feet; 10 sacks of cement for top.

RECEIVED
STATE CORPORATION COMMISSION
MAR 10 1972
CONSERVATION DIVISION
Wichita, Kansas

(If additional description is necessary, use BACK of this sheet)

Name of Plugging Contractor Leo F. Massey

Address Hays, Kansas

STATE OF Kansas, COUNTY OF Sedgwick, ss.

Jon T. Williams, Jr. (employee of owner) or (owner or operator) of the above-described well, being first duly sworn on oath, says: That I have knowledge of the facts, statements, and matters herein contained and the log of the above-described well as filed and that the same are true and correct. So help me God.

(Signature) [Signature]

800 Bitting Building, Wichita, Kansas 67202

(Address)


SUBSCRIBED AND SWORN to before me this 9th day of March, 1972

[Signature]
Vashti Bell

Vashti Bell

Notary Public.

My commission expires September 14, 1973

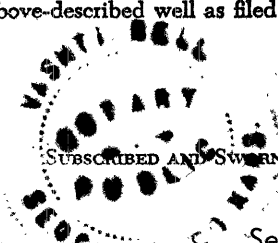

K. T. WOODMAN
RES. PHONE 733 0418
OFFICE PH. AM 5-7650
WICHITA, KANSAS

D. J. IANNITTI
TELEPHONE 653-2381
HOISINGTON, KANSAS

15-163-20421-00-00

WOODMAN & IANNITTI DRILLING COMPANY
Rotary Drilling Contractors

706 UNION NATIONAL BUILDING
WICHITA, KANSAS 67202

March 10, 1972

Company;	Alpine Drilling Co., Inc. & Woodman & Iannitti Drlg. Co.
Farm;	#1 Albright
Location;	NE NE SE
Section;	36-7S-18W
County;	Rooks
Contractor;	Woodman & Iannitti Drilling Co.
Comm;	February 28, 1972
Compl;	March 8, 1972
Total Depth;	3445'
Casing;	8 5/8" @ 229' w/140 sx.
Production;	D & A

Figures Indicate Bottom Of Formations;

55	Clay & Post Rock
220	Shale (Blue) w/ Few Pyrite Streaks
505	Shale
650	Sand
670	Gum
750	Clay & Sand
960	Sand
1040	Red Bed
1310	Red Bed
1315	Shale
1330	Anhy
1645	Shale & Lime
1910	Lime & Shale
2085	Lime & Shale
2270	Lime & Shale
2400	Lime
2550	Lime & Shale
2715	Lime & Shale
2815	Lime
2840	Lime & Shale
2930	Lime
3020	Lime
3078	Lime
3115	Lime
3130	Lime
3196	Lime
3200	Lime
3245	Lime
3313	Lime
3381	Lime & Shale
3384	Lime
3426	Lime
3445	Chert & Total Depth

RECEIVED
STATE CORPORATION COMMISSION
MAR 13 1972
CONSERVATION DIVISION
Wichita, Kansas

Woodman & Iannitti Drlg. Co.
K. T. Woodman
K. T. Woodman