

15-163-20971-00-00

STATE OF KANSAS
STATE CORPORATION COMMISSION

WELL PLUGGING RECORD

Give All Information Completely
Make Required Affidavit
Mail or Deliver Report to
Conservation Division
State Corporation Comm.
245 North Water
Wichita, KS 67202

Rooks County, Sec. 42 Twp. 7S Rge. 19 XE/W
Location as "NE/CNW/SW" or footage from lines

SE SW SW

Lease Owner CHEMCO, INC.

Lease Name Farr Well No. #3

Office Address 905 Republic Bldg. Denver, Colorado 80202

Character of Well (Completed as Oil, Gas or Dry Hole)

Dry Hole

Date Well completed September 23, 1979

Application for plugging filed September 23, 1979

Application for plugging approved September 23, 1979

Plugging commenced September 23, 10:00 A.M. 1979

Plugging completed September 23, 11:30 A.M. 1979

Reason for abandonment of well or producing formation

No Commercial Production

If a producing well is abandoned, date of last production


19

Was permission obtained from the Conservation Division or its agents before plugging was commenced? yes

Name of Conservation Agent who supervised plugging of this well Marvin Schmidt

Producing formation _____ Depth to top _____ Bottom _____ Total Depth of Well _____

Show depth and thickness of all water, oil and gas formations.

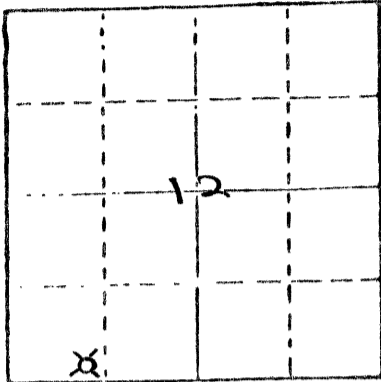

Locate well correctly on above Section Plot

OIL, GAS OR WATER RECORDS

CASING RECORD

FORMATION	CONTENT	FROM	TO	SIZE	PUT IN	PULLED OUT
surface casing	common	0	233.92'	8 5/8"	233.92'	0

Describe in detail the manner in which the well was plugged, indicating where the mud fluid was placed and the method or methods used in introducing it into the hold. If cement or other plugs were used, state the character of same and depth placed, from _____ feet to _____ feet for each plug set.

Plug #1 @ 715' with 70 sxs

Plug #2 @ 230' with 20 sxs

Plug #3 @ 40' with 10 sxs and solid bridge

5 sxs Rat Hole

RECEIVED
STATE CORPORATION COMMISSION

SEP 28 1979

(If additional description is necessary, use BACK of this sheet)

Name of Plugging Contractor Pioneer Drilling Company, Inc. 9-28-79

308 West Mill Plainville, Kansas 67663

STATE OF Kansas COUNTY OF Rooks, ss.
Charles G. Comeau (employee of owner) or (owner or operator)

of the above-described well, being first duly sworn on oath, says: That I have knowledge of the facts, statements, and matters herein contained and the log of the above-described well as filed and that the same are true and correct. So help me God.

(Signature) Charles Comeau

308 West Mill Plainville, Kansas 67663

(Address)

SUBSCRIBED AND SWORN TO before me this 27th day of September, 1979

Connie Jo Austin
Notary Public.

My commission expires _____

