

15-163-00122-00-00

STATE OF KANSAS  
STATE CORPORATION COMMISSION

WELL PLUGGING RECORD


Give All Information Completely  
Make Required Affidavit  
Mail or Deliver Report to:  
Conservation Division  
State Corporation Commission  
800 Bitting Building  
Wichita, Kansas

OR

FORMATION PLUGGING RECORD

Strike out upper line  
when reporting plug-  
ging off formations.

NORTH

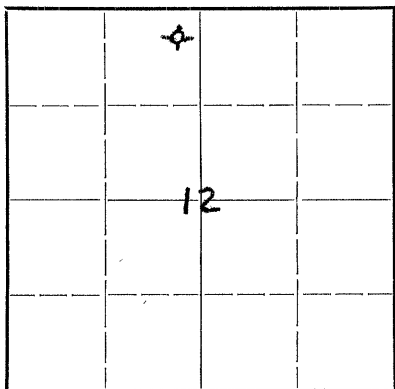

Locate well correctly on above  
Section Plat

Rooks County. Sec. 12 Twp. 7s. Rge. 19W (E) (W)  
Location as "NE 1/4 NW 1/4 SW 1/4" or footage from lines NE NE NW  
Lease Owner The R. W. Rine Drilling Company  
Lease Name Baxter Well No. 1  
Office Address 320 Central Bldg., Wichita, Kansas.  
Character of Well (completed as Oil, Gas or Dry Hole) Dry Hole  
Date well completed March 9, 1948 19.48  
Application for plugging filed March 9, 19.48  
Application for plugging approved March 9, 19.48  
Plugging commenced March 10, 19.48  
Plugging completed March 10, 19.48  
Reason for abandonment of well or producing formation Completed as dry hole.  
If a producing well is abandoned, date of last production 19.  
Was permission obtained from the Conservation Division or its agents before plugging was com-  
menced? Yes.

Name of Conservation Agent who supervised plugging of this well Mr. Wise  
Producing formation None Depth to top Bottom Total Depth of Well 3505 Feet  
Show depth and thickness of all water, oil and gas formations.

OIL, GAS OR WATER RECORDS

CASING RECORD

Formation	Content	From	To	Size	Put In	Pulled Out
				8 5/8 "	217' w/ 200 sacks	None

Describe in detail the manner in which the well was plugged, indicating where the mud fluid was placed and the method or methods used in introducing it into the hold. If cement or other plugs were used, state the character of same and depth placed, from feet to feet for each plug set.

Surface casing; 8 5/8" @ 217'. Circulated with cement (200 sacks).  
Hole full heavy mud from top to bottom. Wood plug @ 218' with 15 sacks  
of cement on top of wood plug. Heavy mud to 20' below cellar. Wood plug  
bridge and 10 sacks cement to the bottom of the cellar, filling hole  
to surface.

(If additional description is necessary, use BACK of this sheet)

Correspondence regarding this well should be addressed to The R. W. Rine Drilling Company, 320 Central Bldg., Wichita, Kansas. 3-12-48

STATE OF KANSAS, COUNTY OF SEDGWICK, ss.  
C. H. Todd (employee of owner) or (owner or operator) of the above-described well,  
being first duly sworn on oath, says: That I have knowledge of the facts, statements, and matters herein contained and the log of the above-described well as filed and that the same are true and correct. So help me God.

(Signature) C. H. Todd  
320 Central Bldg., Wichita, Kansas.  
(Address)

SUBSCRIBED AND SWORN TO before me this 10th day of March, 1948.

My Commission Expires August 27, 1951

Loisita Harvey  
Notary Public.

PLUGGING  
FILE SEC 12 T 7 R 19 W  
BOOK PAGE 17 LINE 24