

15-163-00123-00-00

STATE OF KANSAS
STATE CORPORATION COMMISSION

WELL PLUGGING RECORD

OR

FORMATION PLUGGING RECORD

Strike out upper line when reporting plugging of formations.

Give All Information Completely
Make Required Affidavit
Mail or Deliver Report to:
Conservation Division
State Corporation Commission
800 Bittig Building
Wichita, Kansas

Rooks County. Sec. 5 Twp. 7S Rge. 19 ~~W~~ (W)

Location as "NE $\frac{1}{4}$ NW $\frac{1}{4}$ SW $\frac{1}{4}$ " or footage from lines SE-SE-NW

Lease Owner Cooperative Refinery Association

Lease Name Harlan Well No. 1

Office Address 402 Schweiter Building Wichita, Kansas

Character of Well (completed as Oil, Gas or Dry Hole) Dry Hole

Date well completed June 28 19 48

Application for plugging filed July 20 19 48

Application for plugging approved July 21 19 48


Plugging commenced July 27 19 48

Plugging completed July 30 19 48

Reason for abandonment of well or producing formation Dry

If a producing well is abandoned, date of last production 19

Was permission obtained from the Conservation Division or its agents before plugging was commenced? Yes

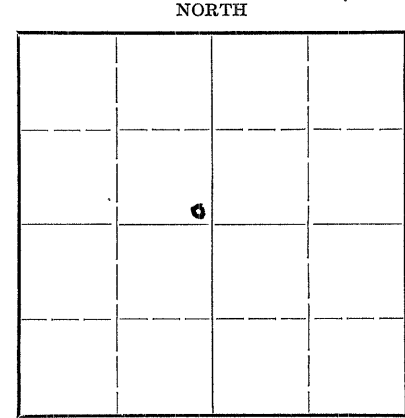

Locate well correctly on above Section Plat

Name of Conservation Agent who supervised plugging of this well M. A. Rives

Producing formation Depth to top Bottom Total Depth of Well 3535 Feet

Show depth and thickness of all water, oil and gas formations.


OIL, GAS OR WATER RECORDS

CASING RECORD

Formation	Content	From	To	Size	Put In	Pulled Out
				8 5/8"	210'	00
				5 1/2"	3474'	2000'

Describe in detail the manner in which the well was plugged, indicating where the mud fluid was placed and the method or methods used in introducing it into the hold. If cement or other plugs were used, state the character of same and depth placed, from feet to feet for each plug set.

Plugged and cemented to 2992'.
Mudded to 315'.
Filled hole to top of surface casing with 100 sacks sulphate cement.
Filled cellar to surface with dirt.

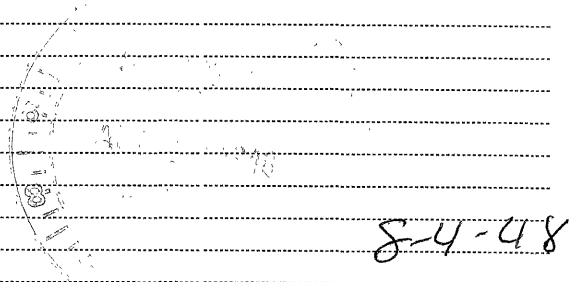

(If additional description is necessary, use BACK of this sheet)

Correspondence regarding this well should be addressed to Cooperative Refinery Association
Address 402 Schweiter Building
Wichita 2, Kansas

STATE OF Kansas, COUNTY OF Sedgwick, ss.
O. W. Gosnell (employee of owner) or (owner/proprietor) of the above-described well,
being first duly sworn on oath, says: That I have knowledge of the facts, statements, and matters herein contained and the log of the above-described well as filed and that the same are true and correct. So help me God.

(Signature) O. W. Gosnell
402 Schweiter Bldg
Wichita 2, Kansas (Address)

SUBSCRIBED AND SWORN TO before me this 2nd day of August, 1948

Ruth Whove
Notary Public.

My commission expires March 5, 1949

