


15-163-21896-00-00

WELL PLUGGING RECORD

Give All Information Completely
 Make Required Affidavit

COUNTY Rooks, SEC. 13 TWP. 7 RGE. 19 E. 1
 Location as in quarters or footage from lines:
770' FSL 850' NW/4

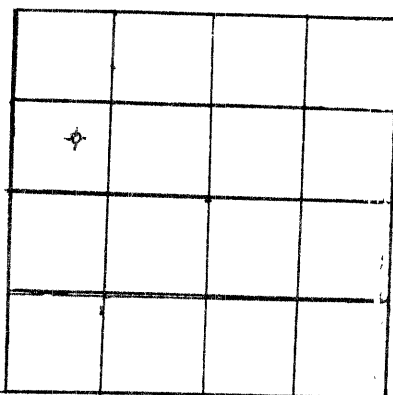

Locate Well
 correctly on above
 Section Platt.

Lease Owner Terra-Max Energy, Inc
 Lease Name Axelson Well No. 1-13
 Office Address Box 848 Monument, Colorado 80132
 Character of Well (Completed as Oil, Gas or Dry Hole): dry
 Date Well Completed December 21, 1982
 Application for plugging filed _____
 Plugging commenced December 21, 1982
 Plugging completed December 21, 1982
 Reason for abandonment of well or producing formation dry

Was permission obtained from the Conservation Division or it's
 Agent's before plugging was commenced? yes

Name of Conservation Agent who supervised plugging of this well Gil Balthazor
 Producing formation none Depth to top N/A bottom T.D. 3450

Show depth and thickness of all water, oil and gas formations.

OIL, GAS OR WATER RECORDS

Casing Records

Formation	Content	From	To	Size	Put in	Pulled Out

Describe in detail the manner in which the well was plugged, indicating where the mud
 fluid was placed and the method or methods used in introducing it into the hold. If cement
 or other plugs were used, state the character of same and depth placed, from _____ feet
 to _____ feet for each plug set.

Bottom Plug 1440' 20sks
 750' 80sks
 245' 40sks
 40' 10sks
 rat hole 10sks
 mouse hole 10sks
 170 sks 50/50 Poz 6% gel 3% CC Wichita, Kansas
 Plug down 4:00 A.M. 12-21-82

RECEIVED
 STATE CORPORATION COMMISSION

JAN 17 1983

CONSERVATION DIVISION

1-17-83

(If additional description is necessary, use BACK of this sheet)

Name of Plugging Contractor Circle M Drilling, Inc.

STATE OF Colorado COUNTY OF El Paso, ss.

M. Kelly Desmarreau (employee of owner) or (owner or operator) of the
 above-described well, being first duly sworn on oath, says: That I have knowledge of the
 facts, statements, and matters herein contained and the log of the above-described well as
 filed and that the same are true and correct. So help me God.

(Signature) M. Kelly Desmarreau

(Address)

SUBSCRIBED AND SWORN TO before me this 12th day of January, 1983

Siene J. King
 Notary Public.

My Commission expires: December 8, 1985