

15-163-20894-00-00


STATE OF KANSAS  
STATE CORPORATION COMMISSION

WELL PLUGGING RECORD

Give All Information Completely  
Make Required Affidavit  
Mail or Deliver Report to  
Conservation Division  
State Corporation Comm.  
245 North Water  
Wichita, KS 67202

Graham County, Sec. 10 Twp. 7S Rge. 19W E/W  
Location as "NE/CNW<sup>1</sup>/SW<sup>1</sup>" or footage from lines  
C NW SW SW

Lease Owner Abercrombie Drilling, Inc.  
Lease Name Graham Well No. 1  
Office Address 801 Union Center, Wichita, Kansas  
Character of Well (Completed as Oil, Gas or Dry Hole) Dry Hole

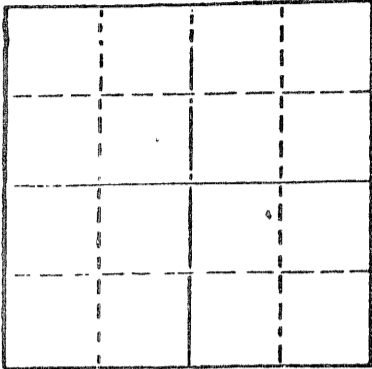

Locate well correctly on above  
Section Plat

Date Well completed Feb. 28 19 79  
Application for plugging filed (verbally) Feb. 28 19 79  
Application for plugging approved (verbally) Feb. 28 19 79  
Plugging commenced Feb. 28 19 79  
Plugging completed Feb. 28 19 79

Reason for abandonment of well or producing formation  
No commercial quantity of oil or gas encountered.  
If a producing well is abandoned, date of last production  
19

Was permission obtained from the Conservation Division or  
its agents before plugging was commenced? Yes

Name of Conservation Agent who supervised plugging of this well Leo Massey  
Producing formation \_\_\_\_\_ Depth to top \_\_\_\_\_ Bottom \_\_\_\_\_ Total Depth of Well 3490'  
Show depth and thickness of all water, oil and gas formations.

OIL, GAS OR WATER RECORDS

CASING RECORD

FORMATION	CONTENT	FROM	TO	SIZE	PUT IN	PULLED OUT

Describe in detail the manner in which the well was plugged, indicating where the mud fluid was placed and the method or methods used in introducing it into the hold. If cement or other plugs were used, state the character of same and depth placed, from \_\_\_\_\_ feet to \_\_\_\_\_ feet for each plug set.

T.D. 3490'  
Set 1st plug at 550' with 70 sacks  
2nd plug at 215' with 20 sacks  
3rd plug at 40' solid bridge with 10 sacks.  
Cemented with 50/50 posmix, 6% gel.  
Plug was down at 1:15 a.m., 2-28-79.

RECEIVED  
STATE CORPORATION COMMISSION

MAR - 7 1979

CONSERVATION DIVISION  
Wichita, Kansas

3-7-79

(If additional description is necessary, use BACK of this sheet)

Name of Plugging Contractor Abercrombie Drilling, Inc.

STATE OF Kansas COUNTY OF Sedgwick, ss.  
Jack L. Partridge, Asst. Sec. -Treas. (employee of owner) or (owner or operator)  
of the above-described well, being first duly sworn on oath, says: That I have knowledge of  
the facts, statements, and matters herein contained and the log of the above-described well  
is filed and that the same are true and correct. So help me God.



(Signature) Jack L. Partridge  
801 Union Center, Wichita, Kansas 67202  
(Address)

SUBSCRIBED AND SWORN TO before me this 5th day of March, 19 79

Sherrie L. Brooks  
Sherrie L. Brooks Notary Public.

My commission expires 8-21-82