


15-163-20811-00-00

STATE OF KANSAS
STATE CORPORATION COMMISSION

WELL PLUGGING RECORD

Give All Information Completely
Make Required Affidavit
Mail or Deliver Report to
Conservation Division
State Corporation Comm.
245 North Water
Wichita, KS 67202

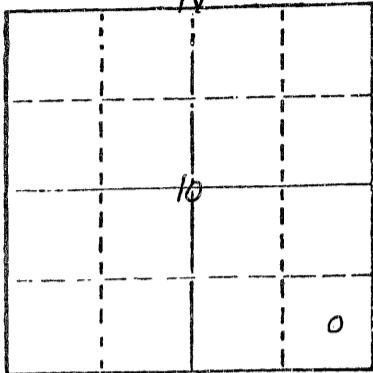

Locate well correctly on above
Section Plot

Rooks _____ County. Sec. 10 Twp. 7 S Rge. 19 N/W
Location as "NE/CNW 1/4 SW 1/4" or footage from lines _____
C NW SE SE
Lease Owner Abercrombie Drilling, Inc.
Lease Name Jackson Well No. 1
Office Address 801 Union Center, Wichita, Kansas 67202
Character of Well (Completed as Oil, Gas or Dry Hole) _____
Dry Hole

Date Well completed June 10, 1978
Application for plugging filed (verbally) June 10, 1978
Application for plugging approved (verbally) June 10, 1978
Plugging commenced June 10, 1978
Plugging completed June 10, 1978

Reason for abandonment of well or producing formation _____
No commercial quantity of oil or gas encountered
If a producing well is abandoned, date of last production _____
19

Was permission obtained from the Conservation Division or
its agents before plugging was commenced? Yes

Name of Conservation Agent who supervised plugging of this well _____
Producing formation _____ Depth to top _____ Bottom _____ Total Depth of Well 3470
Show depth and thickness of all water, oil and gas formations.

OIL, GAS OR WATER RECORDS

CASING RECORD

FORMATION	CONTENT	FROM	TO	SIZE	PUT IN	PULLED OUT

Describe in detail the manner in which the well was plugged, indicating where the mud fluid
was placed and the method or methods used in introducing it into the hold. If cement or other
plugs were used, state the character of same and depth placed, from _____ feet to
_____ feet for each plug set.

Set 1st plug at 550' with 70 sacks
2nd plug at 200' with 20 sacks
3rd plug at 40' with 10 sacks
Cemented with 50/50 posmix, 6% gel.
Plug was down at 9:30 a.m., June 10, 1978.

RECEIVED RECEIVED
STATE CORPORATION COMMISSION STATE CORPORATION COMMISSION
JUN 14 1978 JUN 28 1978
CONSERVATION DIVISION CONSERVATION DIVISION
Wichita, Kansas Wichita, Kansas

(If additional description is necessary, use BACK of this sheet) 628-78
Name of Plugging Contractor Abercrombie Drilling, Inc.

STATE OF KANSAS COUNTY OF SEDGWICK, ss.
Jack L. Partridge, Ass't. Secretary-Treasurer (employee of owner) or (owner or operator)
of the above-described well, being first duly sworn on oath, says: That I have knowledge of
the facts, statements, and matters herein contained and the log of the above-described well
as filed and that the same are true and correct. So help me God.

(Signature) Jack L. Partridge
801 Union Center, Wichita, Kansas 67202
(Address)

SUBSCRIBED AND SWORN TO before me this 13th day of June, 1978
Sandra Richman
Sandra Richman Notary Public.
My commission expires July 21, 1979

