


Give All Information Completely
Make Required Affidavit
Mail or Deliver Report to:
Conservation Division
State Corporation Commission
211 No. Broadway
Wichita, Kansas

WELL PLUGGING RECORD

Rooks County. Sec. 9 Twp. 7S Rge. (E) 19 (W)
Location as "NE/CNW/SW" or footage from lines NE SW SW
Lease Owner A. Scott Ritchie
Lease Name Anderson Well No. "A" #1
Office Address 305 Union Center Bldg. Wichita, Kansas
Character of Well (completed as Oil, Gas or Dry Hole) Dry Hole
Date well completed October 28 1965
Application for plugging filed October 28 1965
Application for plugging approved October 28 1965
Plugging commenced October 28 1965
Plugging completed October 28 1965
Reason for abandonment of well or producing formation No producible shows

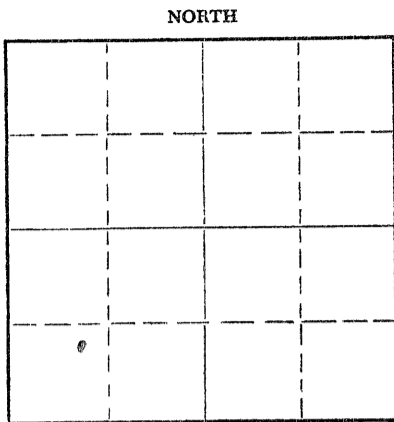

Locate well correctly on above Section Plat

If a producing well is abandoned, date of last production _____ 19____
Was permission obtained from the Conservation Division or its agents before plugging was commenced? Yes

Name of Conservation Agent who supervised plugging of this well Gib Lieker
Producing formation _____ Depth to top _____ Bottom _____ Total Depth of Well _____ Feet
Show depth and thickness of all water, oil and gas formations.

OIL, GAS OR WATER RECORDS

CASING RECORD

FORMATION	CONTENT	FROM	TO	SIZE	PUT IN	PULLED OUT
				8 5/8	217'	

Describe in detail the manner in which the well was plugged, indicating where the mud fluid was placed and the method or methods used in introducing it into the hole. If cement or other plugs were used, state the character of same and depth placed, from _____ feet to _____ feet for each plug set.

Heavy mud to 540', plugged with 20 sx cement through drill pipe.
Heavy mud to 210', wooden plug, 1/4 sx hulls, and 20 sx cement.
Heavy mud to 40', wooden plug, 1/4 sx hulls, and 10 sx cement to bottom of cellar. Job complete 10 PM, 10-28-65.

RECEIVED
STATE CORPORATION COMMISSION
NOV 15 1965
CONSERVATION DIVISION
Wichita, Kansas
11-15-65

(If additional description is necessary, use BACK of this sheet)
Name of Plugging Contractor Garvey Drilling Company
Address RR #2 Great Bend, Kansas

STATE OF Kansas, COUNTY OF Barton, ss.
George M. McKown (employee of owner) or (owner or operator) of the above-described well, being first duly sworn on oath, says: That I have knowledge of the facts, statements, and matters herein contained and the log of the above-described well as filed and that the same are true and correct. So help me God.

(Signature) George M. McKown
Garvey Drilling Co., RR #2, Great Bend, Kansas
(Address)

SUBSCRIBED AND SWORN TO before me this 9th day of November, 19 65

My commission expires May 28, 1969
Richard H. Dumbler Notary Public.