

STATE CORPORATION COMMISSION OF KANSAS
OIL & GAS CONSERVATION DIVISION
WELL COMPLETION OR RECOMPLETION FORM
ACO-1 WELL HISTORY
DESCRIPTION OF WELL AND LEASE

S

API No. 15-163-22,868-0000

County.....Rooks.....

SW..NW..NW. Sec. 16. Twp. 7S. Rge. 20. East
West

.4290..... Ft North from Southeast Corner of Section
.4950..... Ft West from Southeast Corner of Section
(Note: Locate well in section plat below)


Lease Name.....Riseley "B".....Well #. 1.....

Field Name.....Le Sage, East.....

Producing Formation.....Arbuckle.....

Elevation: Ground.....2167'.....KB.....2172'.....

Section Plat

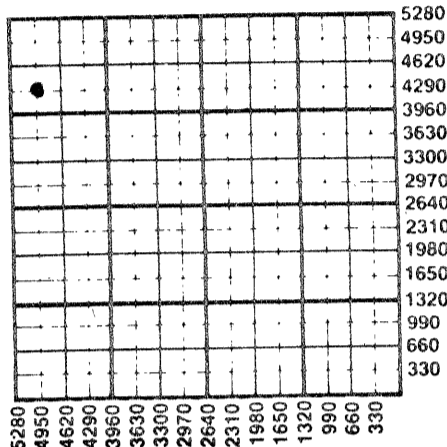

WATER SUPPLY INFORMATION

Disposition of Produced Water: Disposal
Docket # CD-78257..... Repressuring

Questions on this portion of the ACO-1 call:

Water Resources Board (913) 296-3717

Source of Water: Farm Pond

Division of Water Resources Permit #.....

Groundwater.....Ft North from Southeast Corner
(Well)Ft West from Southeast Corner of
Sec Twp Rge East West

Surface Water.....Ft North from Southeast Corner
(Stream, pond, etc).....Ft West from Southeast Corner
Sec Twp Rge East West

Other (explain).....
(purchased from city, R.W.D. #)

Operator: License #7419.....
NameAlcona Oil Company.....
Address2908 Hillcrest Dr.....
City/State/ZipHays, Kansas 67601.....

Purchaser.....Farmland Industries Inc.....

Operator Contact PersonDean LeSage.....
Phone913-628-2899.....

Contractor: License #5665.....
NamePioneer Drilling Company, Inc.....

Wellsite Geologist.....Les LeSage.....
Phone.....301-231-9783.....

Designate Type of Completion
 New Well Re-Entry Workover
 Oil SWD Temp Abd
 Gas Inj Delayed Comp.
 Dry Other (Core, Water Supply etc.)

If OWWO: old well Info as follows:
Operator
Well Name
Comp. DateOld Total Depth.....

WELL HISTORY

Drilling Method:
 Mud Rotary Air Rotary Cable

1-23-86..... 1-28-86..... 2-18-86.....
Spud Date Date Reached TD Completion Date

3685'..... 3654'.....
Total Depth PBDT

Amount of Surface Pipe Set and Cemented at.....feet
Multiple Stage Cementing Collar Used? Yes No
If yes, show depth set.....feet
If alternate 2 completion, cement circulated
from.....feet depth to surface, 575 SX cmt
Cement Company Name Allied Cementing Co.....
Invoice # 46005.....

INSTRUCTIONS: This form shall be completed in duplicate and filed with the Kansas Corporation Commission, 200 Colorado Derby Building, Wichita, Kansas 67202, within 90 days after completion or recompletion of any well. Rule 82-3-130 and 82-3-107 apply.

Information on side two of this form will be held confidential for a period of 12 months if requested in writing and submitted with the form. See rule 82-3-107 for confidentiality in excess of 12 months. One copy of all wireline logs and drillers time log shall be attached with this form. Submit CP-4 form with all plugged wells. Submit CP-111 form with all temporarily abandoned wells.

All requirements of the statutes, rules and regulations promulgated to regulate the oil and gas industry have been fully complied with and the statements herein are complete and correct to the best of my knowledge.


SignatureDean LeSage.....

Title.....operator..... Date 3-13-86

Subscribed and sworn to before me this 13th day of March 1986

Notary Public.....Elaine M. Younger.....

Date Commission Expires June 25 1989

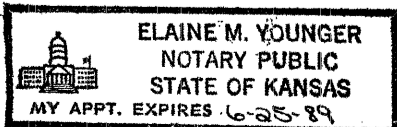

STATE CORPORATION COMMISSION

MAR 14 1986

CONSERVATION DIVISION
Wichita, Kansas

K.C.C. OFFICE USE ONLY
F Letter of Confidentiality Attached
C Wireline Log Received
C Drillers Timelog Received
Distribution
 KCC SWD/Rep NGPA
 KGS Plug Other
(Specify)
.....
.....

Form ACO-1 (7-84)

5-14-86

Sec 16 Twp 7S Rge 20W

SIDE TWO

Operator Name Alcona Oil Company, Inc Lease Name Riseley "B" Well # 1

Sec. 16 Twp. 7s Rge. 20 East West County Rooks

WELL LOG

INSTRUCTIONS: Show important tops and base of formations penetrated. Detail all cores. Report all drill stem tests giving interval tested, time tool open and closed, flowing and shut-in pressures, whether shut-in pressure reached static level, hydrostatic pressures, bottom hole temperature, fluid recovery, and flow rates if gas to surface during test. Attach extra sheet if more space is needed. Attach copy of log.

Drill Stem Tests Taken <input checked="" type="checkbox"/> Yes <input type="checkbox"/> No Samples Sent to Geological Survey <input checked="" type="checkbox"/> Yes <input type="checkbox"/> No Cores Taken <input type="checkbox"/> Yes <input checked="" type="checkbox"/> No	Formation Description <input checked="" type="checkbox"/> Log <input type="checkbox"/> Sample
--	---

DST #1: 3632-3660/30-45-30-45. REC 460' total fluid, 120' gas above fluid. 55' gassy clean oil, 90' slightly mud cut oil, 255' gassy clean oil, 60' heavy oil cut mud

IHP: 1870, IFP: 43, ISIP: 1057, FFP: 173, FSIP: 1029, FHP: 1778.

Anhydrite 1712 (+460) Topeka 3150 (-978) Heebner 3357 (-1185) Toronto 3380 (-1208) Lan/KC 3396 (-1224) Base/KC 3596 (-1424) Arbuckle 3628 (-1456) RTD 3685 LTD 3660	<table border="0" style="width:100%"> <tr> <th style="text-align:left">Name</th> <th style="text-align:left">Top</th> <th style="text-align:left">Bottom</th> </tr> <tr> <td>shale and sand</td> <td>0'</td> <td>145'</td> </tr> <tr> <td>sand and shale</td> <td>145'</td> <td>415'</td> </tr> <tr> <td>sand and shale</td> <td>415'</td> <td>1615'</td> </tr> <tr> <td>shale</td> <td>1615'</td> <td>1713'</td> </tr> <tr> <td>anhydrite</td> <td>1713'</td> <td>1759'</td> </tr> <tr> <td>shale</td> <td>1759'</td> <td>2080'</td> </tr> <tr> <td>shale</td> <td>2080'</td> <td>2229'</td> </tr> <tr> <td>lime and shale</td> <td>2229'</td> <td>2310'</td> </tr> <tr> <td>shale and lime</td> <td>2310'</td> <td>2565'</td> </tr> <tr> <td>shale and lime</td> <td>2565'</td> <td>2780'</td> </tr> <tr> <td>lime and shale</td> <td>2780'</td> <td>3005'</td> </tr> <tr> <td>lime and shale</td> <td>3005'</td> <td>3205'</td> </tr> <tr> <td>lime and shale</td> <td>3205'</td> <td>3375'</td> </tr> <tr> <td>lime and shale</td> <td>3375'</td> <td>3505'</td> </tr> <tr> <td>lime and shale</td> <td>3505'</td> <td>3605'</td> </tr> <tr> <td>lime and shale</td> <td>3605'</td> <td>3660'</td> </tr> <tr> <td>arbuckle</td> <td>3660'</td> <td>3685'</td> </tr> <tr> <td></td> <td></td> <td>R.T.D.</td> </tr>

Cores: None
 Drill Stem Tests: (1) Cheney Testing
 Electric Logs: The Loggers, RA Guard

CASING RECORD <input checked="" type="checkbox"/> New <input type="checkbox"/> Used Report all strings set-conductor, surface, intermediate, production, etc.							
Purpose of String	Size Hole Drilled	Size Casing Set (in O.D.)	Weight Lbs/Ft.	Setting Depth	Type of Cement	#Sacks Used	Type and Percent Additives
Surface Casing	12.1/4"	8.5/8"	20#	251'	.60-40 pos	170	3% sec. 2% gel.
Production	7.7/8"	4.1/2"	9.5#	3660'	.60-40 pos	135	10% salt. 2% gel.
PERFORATION RECORD Shots Per Foot Specify Footage of Each Interval Perforated				Acid, Fracture, Shot, Cement Squeeze Record (Amount and Kind of Material Used) Depth			
2/foot	3632-3644	150 gal 15% INS	4720	1000 gal	INS		
4/foot	3397-3400	750 gal 15% DEM	1500 gal	15%	CRA		
4/foot	3381-3382.5						
6 shots	1600	300 sx 50-50 quick set. Circulated cement to surface.			pos 6% gel. 75 sx 60-40 pos		
TUBING RECORD Size <u>2 3/8"</u> Set At <u>3650'</u> Packer at _____ Liner Run <input type="checkbox"/> Yes <input checked="" type="checkbox"/> No							
Date of First Production	Producing Method						
2-21-86	<input type="checkbox"/> Flowing <input checked="" type="checkbox"/> Pumping <input type="checkbox"/> Gas Lift <input type="checkbox"/> Other (explain).....						
Estimated Production Per 24 Hours	Oil	Gas	Water	Gas-Oil Ratio	Gravity		
	27 Bbls	MCF	9 Bbls	CFPB			

METHOD OF COMPLETION Production Interval

Disposition of gas: Vented Open Hole Perforation
 Sold Other (Specify) 3632-3644
 Used on Lease Dually Completed
 Commingled