

STATE CORPORATION COMMISSION OF KANSAS
OIL & GAS CONSERVATION DIVISION
WELL COMPLETION OR RECOMPLETION FORM
ACO-1 WELL HISTORY
DESCRIPTION OF WELL AND LEASE

Operator: License # 6725
Name Eric Waddell
Address Box 349
City/State/Zip Natoma, KS 67651

Purchaser.....Well never produced.....

Operator Contact Person Eric Waddell
Phone 913-885-4497

Contractor: License #
Name Western Kansas Drilling

Wellsite Geologist Tracy L. Cooley
Phone 913-885-4691

Designate Type of Completion
 New Well Re-Entry Workover
 Oil SWD Temp Abd
 Gas Inj Delayed Comp.
 Dry Other (Core, Water Supply etc.)

If OMWO: old well info as follows:
Operator
Well Name
Comp. Date Old Total Depth

WELL HISTORY

Drilling Method:
 Mud Rotary Air Rotary Cable

.....7/14/87 ..7/19/87... ..7/19/87..
Spud Date Date Reached TD Completion Date

..3531..... ..3525.....
Total Depth PBTD

Amount of Surface Pipe Set and Cemented at 279 feet
Multiple Stage Cementing Collar Used? Yes No
If yes, show depth set.....feet
If alternate 2 completion, cement circulated
from 3525.....feet depth to.....w/.....SX cmf
Cement Company Name Allied Cementing, Inc
Invoice #


API NO. 15-163-22-935
County Rooks
East
SW NW SE Sec 21 Twp 7 Rge 20 West

1650
2310
Ft North from Southeast Corner of Section
Ft West from Southeast Corner of Section
(Note: Locate well in section plat below)

Lease Name Bellerive Well # A-1
Field Name Cocinera

Producing Formation RGR
Elevation: Ground 2052 KB 2057

Section Plat

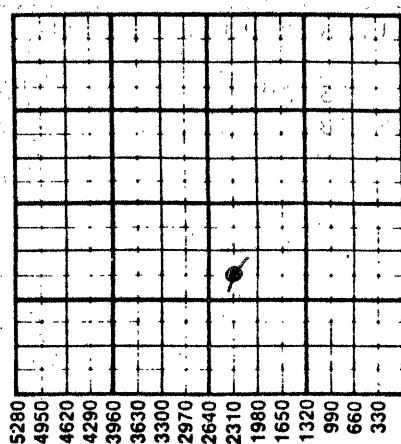

WATER SUPPLY INFORMATION
Disposition of Produced Water: Disposal
Docket # Repressuring

Questions on this portion of the ACO-1 call:
Water Resources Board (913) 296-3717
Source of Water:
Division of Water Resources Permit #
Groundwater.....Ft North from Southeast Corner
(Well)Ft West from Southeast Corner of
Sec Twp Rge East West
Surface Water 2270 Ft North from Southeast Corner
(Stream, pond etc) 2310 Ft West from Southeast Corner
Sec 21 Twp 7 Rge 20 East West
Other (explain)
(purchased from city, R.W.D. #)

INSTRUCTIONS: This form shall be completed in triplicate and filed with the Kansas Corporation Commission, 200 Colorado Derby Building, Wichita, Kansas 67202, within 120 days of the spud date of any well. Rule 82-3-130, 82-3-107 and 82-3-106 apply. Information on side two of this form will be held confidential for a period of 12 months if requested in writing and submitted with the form. See rule 82-3-107 for confidentiality in excess of 12 months. One copy of all wireline logs and drillers time log shall be attached with this form. Submit CP-4 form with all plugged wells. Submit CP-11 form with all temporarily abandoned wells.

All requirements of the statutes, rules and regulations promulgated to regulate the oil and gas industry have been fully complied with and the statements herein are complete and correct to the best of my knowledge.

Signature Tracy L. Cooley
Title Geologist Date 9/10/87

Subscribed and sworn to before me this 16 day of October 19 1987
Notary Public Reva F. Musgrove
Date Commission Expires 3-28-88

K.C.C. OFFICE USE ONLY
Form Letter of Confidentiality Attached
Wireline Log Received
Drillers Time Log Received
Distribution
 KCC SWD/Rep NGPA
 KGS Plug Other
(Specify)
STATE CORPORATION COMMISSION
OCT 19 1987



REVA F. MUSGROVE RECEIVED
State of Kansas CORPORATION COMMISSION
Exp.
Form ACO-1 (5-86)
SEP 14 1987
CONSERVATION DIVISION
Wichita, Kansas
9-14-87
CONSERVATION DIVISION
Wichita, Kansas

Sec 21 Twp 7 Rge 20

SIDE TWO

Operator Name Eric Waddell Lease Name J. Bellerive Well # A-1

Sec. 21 Twp. 7 Rge. 20 East West County Rooks

WELL LOG

INSTRUCTIONS: Show important tops and base of formations penetrated. Detail all cores. Report all drill stem tests giving interval tested, time tool open and closed, flowing and shut-in pressures, whether shut-in pressure reached static level, hydrostatic pressures, bottom hole temperature, fluid recovery, and flow rates if gas to surface during test. Attach extra sheet if more space is needed. Attach copy of log.

Drill Stem Tests Taken Yes No
 Samples Sent to Geological Survey Yes No
 Cores Taken Yes No

Formation Description
 Log Sample

DST#1: LKC 3440-3485 60-30, Rec 10' HMw/O S
 GSO on tool, SIP 203#, FP 48-58#

DST #2: 15-15-30-60, Rec. 5' Mud, SIP48-48#
 FP 48-48/48-48.

Name	Top	Bottom
Anhydrite	1620-1652	
Topeka Lms	3036-3240	
Heebner	3240-3262	
Toronto	3262-3279	
LKC	3279-3480	
Arbuckle	3525-?	

CASING RECORD <input type="checkbox"/> New <input checked="" type="checkbox"/> Used							
Report all strings set-conductor, surface, intermediate, production, etc.							
Purpose of String	Size Hole Drilled	Size Casing Set (in O.D.)	Weight Lbs/Ft.	Setting Depth	Type of Cement	#Sacks Used	Type and Percent Additives
Surface	12 1/4	8 5/8	20#	272	60/40	150	2% gel, 3% c.c.
Production	7 7/8	4 1/2	10#	3522-36	60/40	150	5% lignite, 10% salt
PERFORATION RECORD				Acid, Fracture, Shot, Cement Squeeze Record			
Shots Per Foot	Specify Footage of Each Interval Perforated			(Amount and Kind of Material Used)		Depth	
	SEE ATTACHED SHEET						
TUBING RECORD				Liner Run <input type="checkbox"/> Yes <input type="checkbox"/> No			
Date of First Production	Producing Method <input type="checkbox"/> Flowing <input type="checkbox"/> Pumping <input type="checkbox"/> Gas Lift <input type="checkbox"/> Other (explain) <u>abandoned</u>						
Estimated Production Per 24 Hours	Oil	Gas	Water	Gas-Oil Ratio		Gravity	
	0 Bbls	10 MCF	Bbls	CFPB			

METHOD OF COMPLETION Production Interval

Disposition of gas: Vented Open Hole Perforation
 Sold Other (Specify) _____
 Used on Lease Dually Completed Commingled

RECORDED & INDEXED
 SERIAL TO 5102



ERIC WADDELL COMPANY

Independent Petroleum Geologist

913-885-4497

Complete Geological Services

P. O. Box 349

Natoma, Kansas 67651

PERFORATIONS AND ACID RECORD

4 shots/foot	3472-74	2000 gallons 15% HCl
	3462-64	
	3442-46	Retreat w/ 500# salt plug ahead of 500 gallons of 15% HCl
1 shot/foot	3443	
	3463	
	3473.5	1500 gallons 28% NE HCl
4 shots/foot	3360-62	250 gallons 15% HCl
4 shots/foot	3280-84	
	3262-68	750 gallons of 15% HCl

RECEIVED
STATE CORPORATION COMMISSION
IN
OCT 19 1987
CONSERVATION DIVISION
Wichita, Kansas
SEP 14 1987
CONSERVATION DIVISION
Wichita, Kansas