

CARD MUST BE TYPED

State of Kansas

CARD MUST BE SIGNED

NOTICE OF INTENTION TO DRILL

(see rules on reverse side)

Starting Date September 9, 1987 month day year

API Number 15- 1163-22,943-00-00

OPERATOR: License # 3469 Wallgren Oil Co. Address P.O. Box 184 City/State/Zip Logan, KS 67646 Contact Person Larry Wallgren Phone (913) 689-7503

SW Sec. 17 Twp. 7 S, Rg. 19 West 330 Ft. from South Line of Section 4620 Ft. from East Line of Section

(Note: Locate well on Section Plat on reverse side)

CONTRACTOR: License # 5422 Name Abercrombie Drilling, Inc. City/State Wichita, KS 67202

Nearest lease or unit boundary line 330 feet

County Rooks Lease Name Griebel Well # 3

Ground surface elevation feet MSL

Well Drilled For: Well Class: Type Equipment: Oil SWD Infield Mud Rotary Gas Inj Pool Ext Air Rotary OWWO Exp Wildcat Cable

Domestic well within 330 feet: yes no

Municipal well within one mile: yes no

Surface pipe by Alternate: 1 2 X

If OWWO: old well info as follows:

Operator Well Name N/A Comp Date Old Total Depth

Depth to bottom of fresh water 100'

Depth to bottom of usable water 850' Dakota

Surface pipe planned to be set 200'

Projected Total Depth 3450' feet

Formation Arbuckle

I certify that well will comply with K.S.A. 55-101, et seq., plus eventually plugging hole to KCC specifications.

cementing will be done immediately upon setting production casing. Date 8-25-87 Signature of Operator or Agent Title Agent

For KCC Use:


Conductor Pipe Required feet; Minimum Surface Pipe Required 200 feet per Alt. X 2

This Authorization Expires 2-25-88 Approved By 8-25-87

Must be filed with the K.C.C. five (5) days prior to commencing well  
 This card void if drilling not started within six (6) months of date received by K.C.C.

08-25-1987

**A Regular Section of Land**  
 1 Mile = 5,280 Ft.

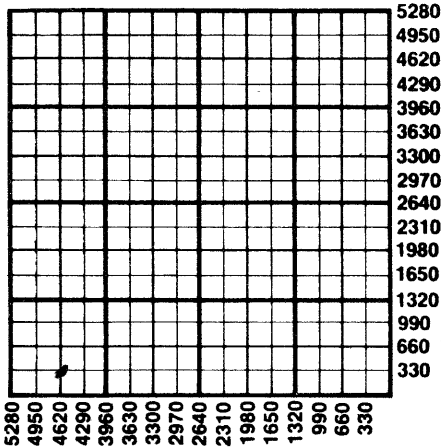

**Important procedures to follow:**

1. Notify District office before setting surface casing.
2. Set surface casing by circulating cement to the top.
3. File completion forms ACO-1 with K.C.C. within 90 days of well completion, following instructions on ACO-1, side 1, and including copies of wireline logs.
4. Notify District office 48 hours prior to old well workover or re-entry.
5. Prior to filing Intent, prepare a proposed plugging plan in case well is D & A, then obtain approval of plan when calling district office prior to setting surface pipe.
6. Submit plugging report (CP-4) to K.C.C. after plugging is completed.
7. Obtain an approved injection docket number before disposing of salt water.
8. Notify K.C.C. within 10 days when injection commences or terminates.
9. If an alternate 2 completion, cement in the production pipe from below any usable water to surface within 120 days of spud date.

KANSAS  
 CONSERVATION DIVISION

AUG 25 1987

RECEIVED  
 STATE CORPORATION COMMISSION

State Corporation Commission of Kansas  
 Conservation Division  
 200 Colorado Derby Building  
 Wichita, Kansas 67202  
 (316) 263-3238