

CARD MUST BE TYPED

State of Kansas

CARD MUST BE SIGNED

### NOTICE OF INTENTION TO DRILL

(see rules on reverse side)

Starting Date January 22, 1986  
month day year

API Number 15— 163-22,868-00-00

OPERATOR: License # 7419

SW NW NW Sec. 16 Twp. 7 S, Rg. 20  East  West

Name Alcona Oil Company

4290 Ft. from South Line of Section

Address 2908 Hillcrest Dr.

4950 Ft. from East Line of Section

City/State/Zip Hays, Kansas 67601

(Note: Locate well on Section Plat on reverse side)

Contact Person Dean LeSage

Phone 913-628-2899

Nearest lease or unit boundary line 330 feet

CONTRACTOR: License # 5665

County Rooks

Name Pioneer Drilling Co., Inc.

Lease Name Riseley "B" Well # 1

City/State Plainville, Kansas 67663

Ground surface elevation 2167 feet MSL

Well Drilled For: Well Class: Type Equipment:

Domestic well within 330 feet:  yes  no

Oil  SWD  Infield  Mud Rotary

Municipal well within one mile:  yes  no

Gas  Inj  Pool Ext.  Air Rotary

Surface pipe by Alternate: 1 2

OWWO  Expl  Wildcat  Cable

Depth to bottom of fresh water 50 ft.

If OWWO: old well info as follows:

Depth to bottom of usable water 1050 ft.

Operator .....

Surface pipe planned to be set 250 ft.

Well Name .....

Projected Total Depth 3700 ft.

Comp Date ..... Old Total Depth .....

Formation Arbuckle

I certify that well will comply with K.S.A. 55-101, et seq., plus eventually plugging hole to KCC specifications.

                     cementing will be done immediately upon setting production casing.

*Real Estate*

Date 1-18 Signature of Operator or Agent Dean LeSage Title operator

For KCC Use:

Conductor Pipe Required ..... feet; Minimum Surface Pipe Required 250 feet per Alt.  2


This Authorization Expires 7-21-86 Approved By 1-21-86

Must be filed with the K.C.C. five (5) days prior to commencing well  
 This card void if drilling not started within six (6) months of date received by K.C.C.

**Important procedures to follow:**

1. Notify District office before setting surface casing.
2. Set surface casing by circulating cement to the top.
3. File completion forms ACO-1 with K.C.C. within 90 days of well completion, following instructions on ACO-1, side 1, and including copies of wireline logs.
4. Notify District office 48 hours prior to old well workover or re-entry.
5. Prior to filing Intent, prepare a proposed plugging plan in case well is D & A, then obtain approval of plan when calling district office prior to setting surface pipe.
6. Submit plugging report (CP-4) to K. C. C. after plugging is completed.
7. Obtain an approved injection docket number before disposing of salt water.
8. Notify K.C.C. within 10 days when injection commences or terminates.
9. If an alternate 2 completion, cement in the production pipe from below any usable water to surface within 120 days of spud date.

**A Regular Section of Land**  
**1 Mile = 5,280 Ft.**

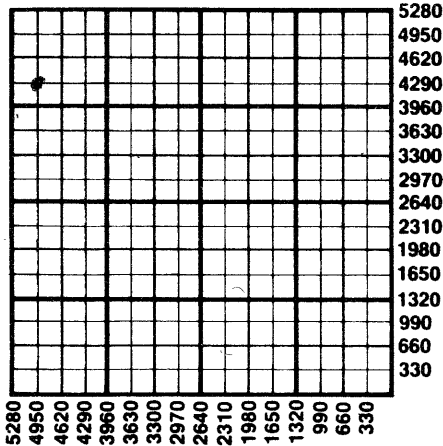

RECEIVED  
 STATE CORPORATION COMMISSION

JAN 21 1986

CONSERVATION DIVISION

State Corporation Commission of Kansas  
 Conservation Division  
 200 Colorado Derby Building  
 Wichita, Kansas 67202  
 (316) 263-3238

1-21-86