

15-163-03931-00-00


STATE OF KANSAS  
STATE CORPORATION COMMISSION

Give All Information Completely  
Make Required Affidavit  
Mail or Deliver Report to:  
Conservation Division  
State Corporation Commission  
211 No. Broadway  
Wichita, Kansas

WELL PLUGGING RECORD

Rook County, Sec. 17 Twp. 7 Rge. 20 (E) (W) X

Location as "NE/CNW/SW" or footage from lines SW SW NW  
Lease Owner Imperial Oil of Kansas  
Lease Name LE Sage Well No. B-#1  
Office Address Wakeeney, Kansas  
Character of Well (completed as Oil, Gas or Dry Hole)  
Date well completed 19  
Application for plugging filed 19  
Application for plugging approved 19  
Plugging commenced 4-18-62 19  
Plugging completed 4-21-62 19  
Reason for abandonment of well or producing formation

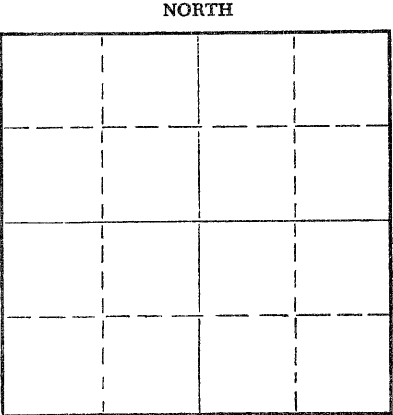

Locate well correctly on above Section Plat

If a producing well is abandoned, date of last production 19  
Was permission obtained from the Conservation Division or its agents before plugging was commenced?

Name of Conservation Agent who supervised plugging of this well Eldon Petty  
Producing formation Depth to top Bottom Total Depth of Well 3608 Feet  
Show depth and thickness of all water, oil and gas formations.

OIL, GAS OR WATER RECORDS

424-62

CASING RECORD

FORMATION	CONTENT	FROM	TO	SIZE	PUT IN	PULLED OUT

RECEIVED  
STATE CORPORATION COMMISSION  
APR 24 1962  
CONSERVATION DIVISION  
Wichita, Kansas

Describe in detail the manner in which the well was plugged, indicating where the mud fluid was placed and the method or methods used in introducing it into the hole. If cement or other plugs were used, state the character of same and depth placed, from feet to feet for each plug set.

Sanded back to 3570'. Mixed and ran 4 sacks cement thru dump bailor.  
Pulled 2 jts. circulated hole with 30 sacks gel and spotted 20 sacks cement at 550'.  
Pulled 12 jts. Spotted 20 sacks cement at 160' - pulled 6 jts.  
Mudded hole to 35', set 5' rock bridge. Mixed and dumped 10 sacks cement to base of cellar.

(If additional description is necessary, use BACK of this sheet)

Name of Plugging Contractor Southwest Casing Pulling Co., Inc.  
Address Box 364, Great Bend, Kansas

STATE OF Kansas, COUNTY OF Barton, ss.  
Southwest Casing Pulling Co., Inc. (employee of owner) or (owner or operator) of the above-described well, being first duly sworn on oath, says: That I have knowledge of the facts, statements, and matters herein contained and the log of the above-described well as filed and that the same are true and correct. So help me God.

(Signature) W. C. Spencer Sec.  
Box 364, Great Bend, Kansas (Address)

SUBSCRIBED AND SWORN TO before me this 23 day of April, 19 62

My commission expires 24 October 1964

Sidney D. Miller Notary Public.



15-163-03931-00-00

RECEIVED  
STATE CORPORATION COMMISSION

APR 10 1962

CONSERVATION DIVISION  
Wichita, Kansas

4-16-62

DRILLER'S LOG

Imperial Oil of Kansas, Inc.  
780 Fourth National Building  
Wichita 2, Kansas

LeSage "B" No. 1  
SW SW NW Sec. 17-7-20W  
Rooks County, Kansas

Total Depth: 3609

Elevation: 2124 K.B.  
Production:

Commenced: 11-22-60 Completed: 12-2-60

Contractor: Imperial Oil of Kansas, Inc.  
Wichita 2, Kansas

Casing Record: Set 8-5/8" Surface pipe at 176' with 150 sacks cement.  
Set 5-1/2" production pipe at 3608' with 150 sax cement.

Figures indicate bottom of formations:

TOPS (Elec. Log)

Surface Rock & Sand	100'	Topeka	3102 (- 977)
Shale & Sand	176'	Heebner	3306 (-1182)
Shale & Shells	1045'	Toronto	3328 (-1204)
Shale & Hard Sand	1200'	Lansing	3344 (-1220)
Dakota Sand	1425'	B/Kansas City	3540 (-1416)
Shale & Shells	1670'	Marmaton	3570 (-1446)
Shale & Red Bed	1694'	Arbuckle	3578 (-1454)
Anhydrite	1725'	Total Depth	3608 (-1484)
Shale & Shells	2170'		
Shale	2420'		
Shale & Lime	3135'		
Lime	3609'		
Rotary Total Depth	3609'		

We hereby certify this to be a correct and accurate log of the above described well, as shown on the daily drilling reports.

IMPERIAL OIL OF KANSAS, INC.

By Raymond L. Bacon  
Raymond L. Bacon

Subscribed and sworn to before me this 22nd day of December, 1960.

My Commission Expires:  
October 12, 1964

Cecilia C. Klug  
Cecilia C. Klug, Notary Public