

15-163-20872-0000

STATE OF KANSAS  
STATE CORPORATION COMMISSION

WELL PLUGGING RECORD

Give All Information Completely  
Make Required Affidavit  
Mail or Deliver Report to  
Conservation Division  
State Corporation Comm.  
245 North Water  
Wichita, KS 67202


Rooks County, Sec. 17 Twp. 7-S Rge. 20 E/W  
Location as "NE/CNW $\frac{1}{4}$ SW $\frac{1}{4}$ " or footage from lines  
NW/4 SW/4 NW/4

Lease Owner Richard Mai Operations  
Lease Name LaSage Well No. 1

Office Address P.O. Box 33, Russell, KS 67665  
Character of Well (Completed as Oil, Gas or Dry Hole)

Dry Hole

Date Well completed 12-10 1978  
Application for plugging filed 12-10- 1978  
Application for plugging approved 12-10- 1978  
Plugging commenced 12-10- 1978  
Plugging completed 12-10- 1978  
Reason for abandonment of well or producing formation

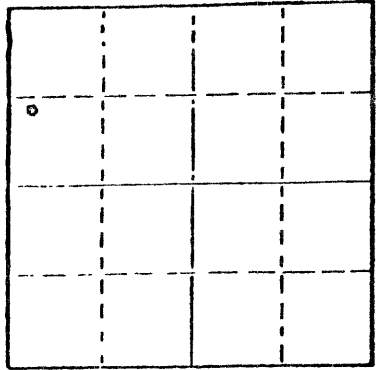

Locate well correctly on above  
Section Plat

If a producing well is abandoned, date of last production 19

Was permission obtained from the Conservation Division or  
its agents before plugging was commenced? Yes verbal

Name of Conservation Agent who supervised plugging of this well Leo Massey

Producing formation Depth to top Bottom Total Depth of Well 3396

Show depth and thickness of all water, oil and gas formations.

OIL, GAS OR WATER RECORDS

CASING RECORD

FORMATION	CONTENT	FROM	TO	SIZE	PUT IN	PULLED OUT
				8 5/8	208	None

Describe in detail the manner in which the well was plugged, indicating where the mud fluid  
was placed and the method or methods used in introducing it into the hold. If cement or other  
plugs were used, state the character of same and depth placed, from feet to  
feet for each plug set.

Hole filled with mud through drill pipe.  
Spotted 70 sack cement plug @ 720'  
Spotted 20 sack cement plug @ 185'  
Spotted 10 sack cement plug @ 40'  
Spotted 2 sack cement plug rat hole

RECEIVED  
STATE CORPORATION COMMISSION

JAN - 2 1979

(If additional description is necessary, use BACK of this sheet)

Name of Plugging Contractor 1-2-79

STATE OF OKLAHOMA COUNTY OF GARFIELD, ss.  
Boyd D. Phillips, Tornado Drilling (employee of owner) or (owner or operator)  
of the above-described well, being first duly sworn on oath, says: That I have knowledge of  
the facts, statements, and matters herein contained and the log of the above-described well  
as filed and that the same are true and correct. So help me God.

(Signature) Boyd Phillips  
P.O. Box 706, Enid, OK 73701  
(Address)

SUBSCRIBED AND SWORN TO before me this 28th day of December, 19 78

Deborah Allen  
Notary Public.

My commission expires Aug. 25, 1982