

20946
15-163-2088-00-00


STATE OF KANSAS
STATE CORPORATION COMMISSION

WELL PLUGGING RECORD

Give All Information Completely
Make Required Affidavit
Mail or Deliver Report to
Conservation Division
State Corporation Comm.
245 North Water
Wichita, KS 67202

Rooks County, Sec. 11 Twp. 7S Rge. 19 E/W
Location as "NE/CNW/SW" or footage from lines
SE SE SE

Lease Owner Liberty Enterprises, Inc,
Lease Name Liebenau Well No. #1
Office Address 308 West Mill Plainville, Ks. 67663
Character of Well (Completed as Oil, Gas or Dry Hole)
Dry Hole

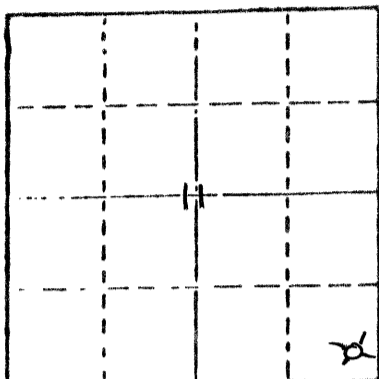

Locate well correctly on above Section Plat

Date Well completed July 24, 1979
Application for plugging filed July 24, 1979
Application for plugging approved July 24, 1979
Plugging commenced July 24, 12:00 P.M. 1979
Plugging completed July 24, 1:30 P.M. 1979

Reason for abandonment of well or producing formation
No Commercial Production

If a producing well is abandoned, date of last production
19

Was permission obtained from the Conservation Division or its agents before plugging was commenced? yes

Name of Conservation Agent who supervised plugging of this well Leo. F. Massey

Producing formation Depth to top Bottom Total Depth of Well

Show depth and thickness of all water, oil and gas formations.

OIL, GAS OR WATER RECORDS

CASING RECORD

FORMATION	CONTENT	FROM	TO	SIZE	PUT IN	PULLED OUT
surface casing	common	0	207.93	8 5/8"	207.93'	0

Describe in detail the manner in which the well was plugged, indicating where the mud fluid was placed and the method or methods used in introducing it into the hold. If cement or other plugs were used, state the character of same and depth placed, from feet to feet for each plug set.

Plug #1 @ 680' with 70 sxs
Plug #2 @ 200' with 20 sxs
Plug #3 @ 40' with solid bridge and wooden plug and 10 sxs
Rathole plugged with 3 sxs
Total 103 sxs 50-50 p6z

RECEIVED
STATE CORPORATION COMMISSION
JUL 26 1979

CONSERVATION DIVISION
Wichita, Kansas

7-26-79

(If additional description is necessary, use BACK of this sheet)

Name of Plugging Contractor Pioneer Drilling Company, Inc.
308 West Mill Plainville, Kansas 67663

STATE OF Kansas COUNTY OF Rooks, ss.
Charles G. Comeau (employee of owner) or (owner or operator)

of the above-described well, being first duly sworn on oath, says: That I have knowledge of the facts, statements, and matters herein contained and the log of the above-described well as filed and that the same are true and correct. So help me God.

(Signature) Charles G. Comeau
308 West Mill Plainville, Kansas 67663

(Address)

SUBSCRIBED AND SWORN TO before me this 25th day of July, 1979

Connie Jo Austin
Notary Public.

My commission expires

