


STATE OF KANSAS
 STATE CORPORATION COMMISSION
 200 Colorado Derby Bldg.
 Wichita, Kansas 67202

Form CP-4
 Rev. 12-15-80

WELL PLUGGING RECORD 15-163-21934-00-00

Give All Information Completely
 Make Required Affidavit

COUNTY _____ ROOKS SEC. 8 TWP. 7S RGE. 19W E/W
 Location as in quarters or footage from lines:
E/2 SW SW

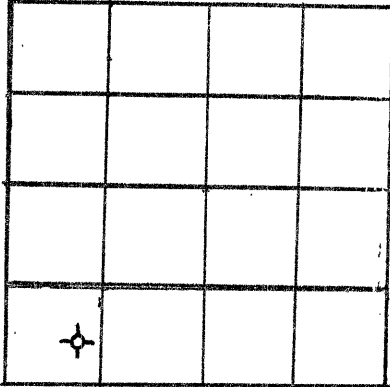

Locate Well
 correctly on above
 Section Platt.

Lease Owner Chief Drilling Co., Inc.
 Lease Name DRYDEN Well No. #1
 Office Address 905 Century Plaza Wichita, Kansas 67202
 Character of Well (Completed as Oil, Gas or Dry Hole): D.H.
 Date Well Completed 2-08-83
 Application for plugging filed 2-08-83
 Plugging commenced 2-08-83
 Plugging completed 2-08-83
 Reason for abandonment of well or producing formation _____

Was permission obtained from the Conservation Division or it's
 Agent's before plugging was commenced? yes

Name of Conservation Agent who supervised plugging of this well Gilbert Leiker

Producing formation _____ Depth to top _____ bottom T.D. 3458'

Show depth and thickness of all water, oil and gas formations.

OIL, GAS OR WATER RECORDS Casing Record

Formation	Content	From	To	Size	Put in	Pulled Out
surface	7 jts. 20#			8 5/8"	240' set @	243'

Describe in detail the manner in which the well was plugged, indicating where the mud
 fluid was placed and the method or methods used in introducing it into the hold. If cement
 or other plugs were used, state the character of same and depth placed, from _____ feet
 to _____ feet for each plug set.

Plugged w/210 sx., 50-50 pos mix, 6% gel, 3% c.c., 1st plug @ 3458' w/
 25 sx., 2nd plug @ 1560' w/25 sx., 3rd plug @ 840' w/100 sx., 4th plug
 @ 300' w/40 sx., solid bridge plug from 0 to 40' w/10 sx., 10 sx., in
 rat hole, started @ 6:30 a.m. completed @ 9:15 a.m. state plugger Gilbert
 Leiker

(If additional description is necessary, use BACK of this sheet)

Name of Plugging Contractor Warrior Drilling Co., Rig #1 Harold Dinkel

STATE OF KANSAS COUNTY OF SEDGWICK, ss.

F.W. SHELTON, JR. (employee of owner) or ~~(owner or operator)~~ of the
 above-described well, being first duly sworn on oath, says: That I have knowledge of the
 facts, statements, and matters herein contained and the log of the above-described well as
 filed and that the same are true and correct. So help me God.


RECEIVED
 STATE CORPORATION COMMISSION

(Signature) F.W. Shelton, Jr.
 (Address) F.W. Shelton, Jr., Vice Pres.

FEB 16 1983

SUBSCRIBED AND SWORN TO before me this 9th day of February, 19 83

CONSERVATION DIVISION
 Wichita, Kansas

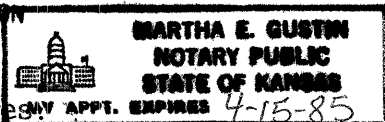

Martha E. Gustin
 Martha E. Gustin Notary Public.

My Commission expires _____