


15-163-00803-00-00

STATE OF KANSAS  
STATE CORPORATION COMMISSION

Give All Information Completely  
Make Required Affidavit  
Mail or Deliver Report to:  
Conservation Division  
State Corporation Commission  
212 North Market, Insurance Bldg.  
Wichita, Kansas

WELL PLUGGING RECORD

NORTH

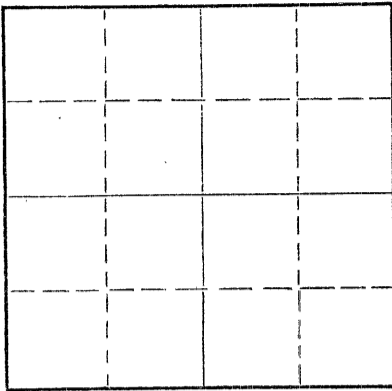

Locate well correctly on above  
Section Plat

ROOKS

County. Sec. 8 Twp. 7S Rge. 19W (E) (W)

Location as "NE/CNW/SW" or footage from lines NE NW SE

Lease Owner SIERRA PETROLEUM CO., INC.

Lease Name DRYDEN Well No. 1

Office Address 208 Petroleum Building, Wichita, Kansas

Character of Well (completed as Oil, Gas or Dry Hole) Dry Hole

Date well completed 4-1-60 19

Application for plugging filed 4-1-60 19

Application for plugging approved 4-1-60 19

Plugging commenced 4-1-60 19

Plugging completed 4-1-60 19

Reason for abandonment of well or producing formation Dry Hole

If a producing well is abandoned, date of last production 19

Was permission obtained from the Conservation Division or its agents before plugging was commenced? Yes

Name of Conservation Agent who supervised plugging of this well Mr. Eldon Petty, Hays, Kansas

Producing formation Depth to top Bottom Total Depth of Well Feet

Show depth and thickness of all water, oil and gas formations.

OIL, GAS OR WATER RECORDS

CASING RECORD

FORMATION	CONTENT	FROM	TO	SIZE	PUT IN	PULLED OUT
				8-5/8"	183'	

Describe in detail the manner in which the well was plugged, indicating where the mud fluid was placed and the method or methods used in introducing it into the hole. If cement or other plugs were used, state the character of same and depth placed, from feet to feet for each plug set.

PLUGGED: Filled hole with heavy mud 3550' up to 550'.  
Bridge using 1/3 sk. hulls, wood plug, 20 sx. cement through drill pipe. Filled with heavy mud up to 160'. Bridge using 1/3 sk. hulls, wood plug, 15 sx. cement through drill pipe. Filled hole with mud up to 40'. Bridge using 1/2 sk. hulls, wood plug, 10 sx. cement up to cellar zero.  
Job completed 10:30 p.m. - 4-1-60

State Supervisor: Mr. Eldon Petty  
Hays, Kansas

RECEIVED  
STATE CORPORATION COMMISSION  
APR 5 1960  
CONSERVATION DIVISION  
Wichita, Kansas

Name of Plugging Contractor SIERRA PETROLEUM CO., INC. 4-3-60  
Address 208 Petroleum Building, Wichita, Kansas

STATE OF KANSAS, COUNTY OF RUSSELL, ss.  
C. T. HONAKER (employee of owner) or (owner or operator) of the above-described well, being first duly sworn on oath, says: That I have knowledge of the facts, statements, and matters herein contained and the log of the above-described well as filed and that the same are true and correct. So help me God.

(Signature) C. T. Honaker C. T. HONAKER, DRLG. SUPT.

Box 232, Russell, Kansas  
(Address)

SUBSCRIBED AND SWORN TO before me this 4th day of APRIL 1960

Notary Public.

My commission expires 10-17-63

