

CARD MUST BE TYPED

State of Kansas
NOTICE OF INTENTION TO DRILL
(see rules on reverse side)

CARD MUST BE SIGNED

Starting Date: 11-12-85
month day year 9:10

API Number 15- 163-22,81400-00

OPERATOR: License # 5352 70'

W of NE SE SW Sec 18 Twp 7 S, Rge 19 East West
(location)

Name Baird Oil Company

Address Box 428

City/State/Zip Logan, KS 67646

Contact Person Jack L. Partridge

Phone 316-262-1841

990 Ft North from Southeast Corner of Section

3040 Ft West from Southeast Corner of Section

(Note: Locate well on Section Plat on reverse side)

CONTRACTOR: License # 5422

Nearest lease or unit boundary line 330 feet.

County Rooks

Lease Name Rose Culp Well# 2

Domestic well within 330 feet: yes no

Municipal well within one mile: yes no

Name Abercrombie Drilling, Inc.

City/State Wichita, KS

Well Drilled For: Well Class: Type Equipment:
 Oil Swd Infield Mud Rotary
 Gas Inj Pool Ext. Air Rotary
 OWWO Expl Wildcat Cable

Depth to Bottom of fresh water 100 feet

Lowest usable water formation Dakota

Depth to Bottom of usable water 1400 925 feet

Surface pipe by Alternate: 1 2

Surface pipe to be set 250 feet

Conductor pipe if any required None feet

If OWWO: old well info as follows:

Operator

Well Name

Comp Date Old Total Depth

Projected Total Depth 3650 feet

Projected Formation at TD Arbuckle

Expected Producing Formations Arbuckle

1922 Ground surface elevation feet MSL

This Authorization Expires 5-12-86

Approved By 11-12-85

I certify that we will comply with K.S.A. 55-101, et seq., plus eventually plugging hole to K.C.C. specifications.

Date 11-12-85 Signature of Operator or Agent

Jack L. Partridge
Jack L. Partridge

Title V.P. Abercrombie Drilling, Inc.


Must be filed with the K.C.C. five (5) days prior to commencing well
 This card void if drilling not started within six (6) months of date received by K.C.C.

RECEIVED
 STATE CORPORATION COMMISSION
 NOV 12 1985

Important procedures to follow :

A Regular Section of Land
 1 Mile = 5,280 Ft.

CONSERVATION DIVISION District office before setting surface casing.
 Wichita, Kansas

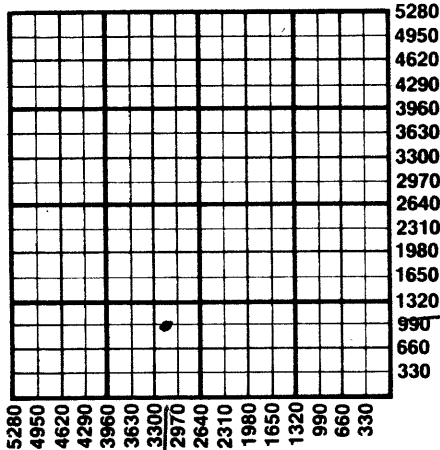

1. Notify District office before setting surface casing.
2. Set surface casing by circulating cement to the top.
3. File completion forms ACO-1 with K.C.C. within 90 days of well completion, following instructions on ACO-1, side 1, and including copies of wireline logs.
4. Notify District office 48 hours prior to old well workover or re-entry.
5. Prior to plugging, prepare a plugging plan, then obtain agreement from the appropriate district office for an approved plugging plan.
6. Submit plugging report (CP-4) to K.C.C. after plugging is completed.
7. Obtain an approved injection docket number before disposing of salt water.
8. Notify K.C.C. within 10 days when injection commences or terminates.
9. If an alternate 2 completion, cement in the production pipe from below any usable water to surface within 120 days of spud date.

State Corporation Commission of Kansas
 Conservation Division
 200 Colorado Derby Building
 Wichita, Kansas 67202
 (316) 263-3238