

CARD MUST BE TYPED

State of Kansas
NOTICE OF INTENTION TO DRILL

(see rules on reverse side)

CARD MUST BE SIGNED

Starting Date: 10 20 84
month day year

API Number 15- 163-22,517-00-00

OPERATOR: License # 5140
Name Frontier Oil Company
Address 1720 Kansas State Bank Building
City/State/Zip Wichita, Kansas 67202
Contact Person George A. Angle
Phone 316-263-1201

Apx. SW NE SW 24 7S 19W East
(location) Sec Twp S, Rge West

1690
3630 Ft North from Southeast Corner of Section
Ft West from Southeast Corner of Section
(Note: Locate well on Section Plat on reverse side)

CONTRACTOR: License # 5302
Name Red Tiger Drilling Co.
City/State Wichita, Kansas 67202

Nearest lease or unit boundary line 990 feet.
County Rooks

Lease Name Axelson Well# 6

Domestic well within 330 feet: yes No
Municipal well within one mile: yes No

Well Drilled For: Well Class: Type Equipment:
 Oil Swd Infield Mud Rotary
 Gas Inj Pool Ext. Air Rotary
 OWWO Expl Wildcat Cable

Depth to Bottom of fresh water 54 feet
Lowest usable water formation Dakota
Depth to Bottom of usable water 800 feet

If OWWO: old well info as follows:

Operator
Well Name
Comp Date Old Total Depth
Projected Total Depth 3400 feet
Projected Formation at TD Arbuckle
Expected Producing Formations Arbuckle

Surface pipe by Alternate: 1 2
Surface pipe to be set 200 feet
Conductor pipe if any required N/A feet
Ground surface elevation 1920 GR-Laughlin-Simmons feet MSL

This Authorization Expires 4-11-85
Approved By 10-11-84 *George A. Angle*

I certify that we will comply with K.S.A. 55-101, et seq., plus event... plugging hole to K.C. specific...

Date 10/11/84 Signature of Operator or Agent


George A. Angle
Title OWNER

Must be filed with the K.C.C. five (5) days prior to commencing well
This card void if drilling not started within six (6) months of date received by K.C.C.

RECEIVED
STATE CORPORATION COMMISSION

OCT 11 1984
A Regular Section of Land
1 Mile = 5,280 Ft.
Wichita, Kansas

10-11-84

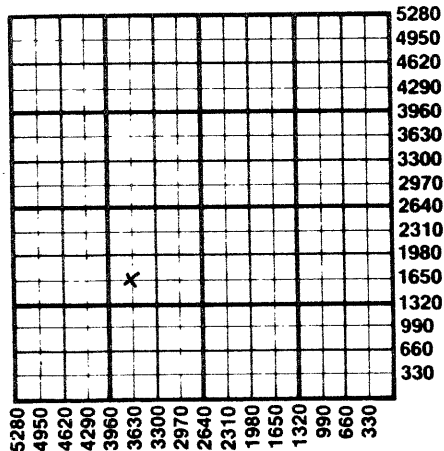

Important procedures to follow:

1. Notify District office before setting surface casing.
2. Set surface casing by circulating cement to the top.
3. File completion forms ACO-1 with K.C.C. within 90 days of well completion, following instructions on ACO-1, side 1, and including copies of wireline logs.
4. Notify District office 48 hours prior to old well workover or re-entry.
5. Prior to plugging, prepare a plugging plan, then obtain agreement from the appropriate district office for an approved plugging plan.
6. Submit plugging report (CP-4) to K.C.C. after plugging is completed.
7. Obtain an approved injection docket number before disposing of salt water.
8. Notify K.C.C. within 10 days when injection commences or terminates.
9. If an alternate 2 completion, cement in the production pipe from below any usable water to surface within 120 days of spud date.

State Corporation Commission of Kansas
Conservation Division
200 Colorado Derby Building
Wichita, Kansas 67202
(316) 263-3238