

CARD MUST BE TYPED

State of Kansas
NOTICE OF INTENTION TO DRILL
(see rules on reverse side)

CARD MUST BE SIGNED

Starting Date: 9 27 84
month day year 2/10

API Number 15- 163-22,496-00-00

OPERATOR: License # 5140
Name .. Frontier Oil Company
Address 1720 Kansas State Bank Bldg.
City/State/Zip .. Wichita, Kansas 67202
Contact Person .. George A. Angle
Phone .. 316-263-1201

SE NE SW Sec 24 Twp 7S S, Rge 19W East
(location) West

1650 Ft North from Southeast Corner of Section
2970 Ft West from Southeast Corner of Section
(Note: Locate well on Section Plat on reverse side)

CONTRACTOR: License # 5302
Name .. Red Tiger Drilling Co.
City/State .. Wichita, Kansa. 67202

Nearest lease or unit boundary line 330 feet.
County Rooks

Lease Name .. Axelson Well# 5

Domestic well within 330 feet : yes no

Municipal well within one mile : yes no

Well Drilled For: Well Class: Type Equipment:
 Oil Swd Infield Mud Rotary
 Gas Inj Pool Ext. Air Rotary
 OWWO Expl Wildcat Cable

Depth to Bottom of fresh water 54 feet

Lowest usable water formation Dakota

Depth to Bottom of usable water 700 800 feet

Surface pipe by Alternate : 1 2

Surface pipe to be set 250 feet

Conductor pipe if any required N/A feet

Ground surface elevation 1922 Gr 1913 MAP feet MSL

This Authorization Expires 3-25-85

Approved By George A. Angle
9-25-84

I certify that we will comply with K.S.A. 55-101, et seq., plus event drilling hole to K.C. specifications.

Date 9/25/84 Signature of Operator or Agent

George A. Angle
OWNER

Title

Surface explanation satisfactory JG

Must be filed with the K.C.C. five (5) days prior to commencing well
This card void if drilling not started within six (6) months of date received by K.C.C.


RECEIVED
STATE CORPORATION COMMISSION

SEP 25 1984

9-29-84

A Regular Section of Land
1 Mile = 5,280 Ft.

SECTIONAL ASSIGNMENT

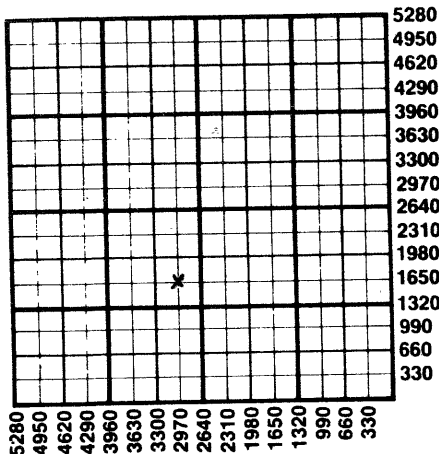

Important procedures to follow:

1. Notify District office before setting surface casing.
2. Set surface casing by circulating cement to the top.
3. File completion forms ACO-1 with K.C.C. within 90 days of well completion, following instructions on ACO-1, side 1, and including copies of wireline logs.
4. Notify District office 48 hours prior to old well workover or re-entry.
5. Prior to plugging, prepare a plugging plan, then obtain agreement from the appropriate district office for an approved plugging plan.
6. Submit plugging report (CP-4) to K.C.C. after plugging is completed.
7. Obtain an approved injection docket number before disposing of salt water.
8. Notify K.C.C. within 10 days when injection commences or terminates.
9. If an alternate 2 completion, cement in the production pipe from below any usable water to surface within 120 days of spud date.

State Corporation Commission of Kansas
Conservation Division
200 Colorado Derby Building
Wichita, Kansas 67202
(316) 263-3238