

CARD MUST BE TYPED

State of Kansas

CARD MUST BE SIGNED

# NOTICE OF INTENTION TO DRILL

(see rules on reverse side)

Expected Spud Date..... 9/18/87  
month day year

API Number 15- 065-22,407-00-00 IRREGULAR SECTION DRY

OPERATOR: License # 4767  
Name Ritchie Exploration, Inc.  
Address 125 N. Market, Suite 1000  
City/State/Zip Wichita, KS 67202  
Contact Person Jeff Christian  
Phone 316/267-4375

Appr. SE SW NW Sec... 1 Twp... 7 S, Rg... 21 X East West  
2970 Ft. from South Line of Section  
4290 4190 Ft. from East Line of Section

(Note: Locate well on Section Plat on reverse side)

CONTRACTOR: License # 6033  
Name Murfin Drilling Co.  
City/State Wichita, KS 67202

Nearest lease or unit boundary line ..... 990 feet  
County..... Graham

Lease Name Brad. Trexler Well # 1

Ground surface elevation ..... 2184 feet MSL

Well Drilled For: Well Class: Type Equipment:  
X Oil Storage Infield X Mud Rotary  
Gas Inj Pool Ext. Air Rotary  
OWWO Expl X Wildcat Cable

Domestic well within 330 feet: yes X no

Municipal well within one mile: yes X no

Depth to bottom of fresh water..... 100

Depth to bottom of usable water ..... 1200

Surface pipe by Alternate: 1 2 X

Surface pipe planned to be set ..... 200

Conductor pipe required.....

Projected Total Depth ..... 3750 feet

Formation..... Arbuckle

I certify that well will comply with K.S.A. 55-101, et seq., plus eventually plugging hole to KCC specifications.

Date 9/10/87 Signature of Operator or Agent Jeff Christian Title Geologist

For KCC Use:

Conductor Pipe Required ..... feet: Minimum Surface Pipe Required ..... 200 feet per Alt. X 2


This Authorization Expires 3-14-88 Effective 9/19/87 Approved By 9-14-87

Must be filed with the K.C.C. five (5) days prior to commencing well  
 This card void if drilling not started within six (6) months of date received by K.C.C.

**Important procedures to follow:**

1. Notify District office before setting surface casing.
2. Set surface casing by circulating cement to the top.
3. File completion forms ACO-1 with K.C.C. within 120 days of well spud date, following instructions on ACO-1, side 1, and including copies of wireline logs.
4. Notify District office 48 hours prior to old well workover or re-entry.
5. Prior to filing Intent, prepare a proposed plugging plan in case well is D & A, then obtain approval of plan when calling district office prior to setting surface pipe.
6. Submit plugging report (CP-4) to K.C.C. after plugging is completed.
7. Obtain an approved injection docket number before disposing of salt water.
8. Notify K.C.C. within 10 days when injection commences or terminates.
9. If an alternate 2 completion, cement in the production pipe from below any usable water to surface within 120 days of spud date.

**A Regular Section of Land**  
**1 Mile = 5,280 Ft.**

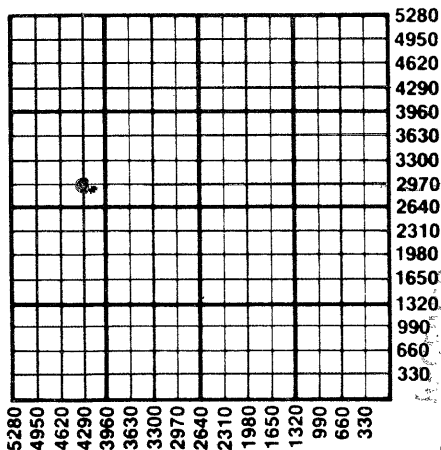

STATE CORPORATION COMMISSION

CP-1 1987

CONSERVATION DIVISION  
 WICHITA, KANSAS

9-11-87

State Corporation Commission of Kansas  
 Conservation Division  
 200 Colorado Derby Building  
 Wichita, Kansas 67202-1212  
 (316) 263-3238