

15-163-03925-00-00

STATE OF KANSAS
STATE CORPORATION COMMISSION

Give All Information Completely
Make Required Affidavit
Mail or Deliver Report to:

Conservation Division
State Corporation Commission
800 Biting Building
Wichita, Kansas


WELL PLUGGING RECORD

OR

FORMATION PLUGGING RECORD

Strike out upper line
when reporting plug-
ging off formations.

NORTH

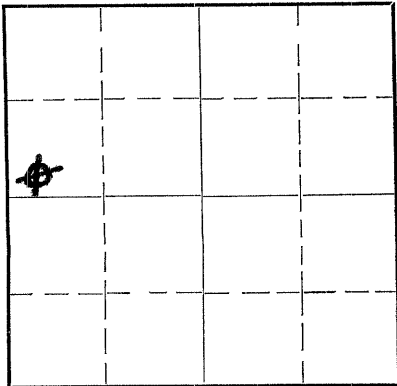

Locate well correctly on above
Section Plat

Rooks County. Sec. 35. Twp. 7S. Rge. (E) 19. (W)
Location as "NE $\frac{1}{4}$ NW $\frac{1}{4}$ SW $\frac{1}{4}$ " or footage from lines SW cor SW $\frac{1}{4}$ - NW $\frac{1}{4}$
Lease Owner Producer's Oil Co. & L.C.D. Drlg. & Dev. Co
Lease Name Mira Ham Well No. 1
Office Address Wichita, Kansas Plainville, Kansas
Character of Well (Completed as Oil, Gas or Dry Hole) Dry Hole
Date, well completed Jan. 27th 1939
Application for plugging filed Jan. 30th 1939
Application for plugging approved Jan. 30th 1939
Plugging Commenced Feb. 23rd 1939
Plugging Completed May 5 1939
Reason for abandonment of well or producing formation Non-Productive

If a producing well is abandoned, date of last production 193
Was permission obtained from the Conservation Division or its agents before plugging was commenced?
Yes

Name of Conservation Agent who supervised plugging of this well Ed Shield
Producing formation Depth to top Bottom Total Depth of Well 3372 Feet.
Show depth and thickness of all water, oil and gas formations.


OIL, GAS OR WATER RECORDS

CASING RECORD

Formation	Content	From	To	Size	Put In	Pulled Out
sand	water	460	467	12 $\frac{1}{2}$	308	240
sand & shale breaks	water	500	1045	10	1298	950
sand	water	1287	1300	8 $\frac{1}{2}$	2818	2818
limes line	water	1385	1390	6 5/8	3050	3050
broken line	water	1760	1790	5 3/16 liner	365	365
sand	water	2680	2690			
Siliceous lime	water	3050	3372			

Describe in detail the manner in which the well was plugged, indicating where the mud fluid was placed and the method or methods used in introducing it into the hole. Cement or other plugs were used, ~~3225-3245~~ ^{and} placed, from 3245-3225 feet to 318-288 feet for each plug set.

heavy mud from 3372-3245
Cement 3245-3225
heavy mud 3225- 308
Cal-seal cement 308- 288 Pumped in by Halliburton
heavy mud 288- 10
Bridge at - 10
Cement 10- to top of hole at bottom of cellar.

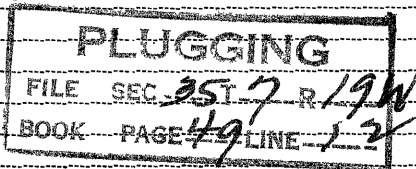

5-15-39

(If additional description is necessary, use BACK of this sheet)

Correspondence regarding this well should be addressed to L. C. D. Drilling & Development Co.,
Address P. O. Box 253, Plainville, Kansas.

STATE OF _____, COUNTY OF _____, ss.

L. E. Dean, Pres of LCD Drlg. & Dev. Co. (employee of owner) or (owner or operator) of the above-described well,
being first duly sworn on oath, says: That I have knowledge of the facts, statements, and matters herein contained and the log of the above-described well as filed and that the same are true and correct. So help me God.

(Signature)

Plainville, Kan. Box 253
(Address)

SUBSCRIBED AND SWORN to before me this 13th day of May, 1939

My commission expires

March 6, 1940

17-3443

3-38-3M

Notary Public.