

15-163-00460-00-01

STATE OF KANSAS
STATE CORPORATION COMMISSION

WELL PLUGGING RECORD

Give All Information Completely
Make Required Affidavit
Mail or Deliver Report to:
Conservation Division
State Corporation Commission
212 No. Market
Wichita, Kansas

Rooks County, Sec. 27 Twp. 7 Rge. 19 (E) W (W)

Location as "NE/CNW%SW%" or footage from lines NE NW NE

Lease Owner Edmiston Oil Co. Wichita, Kansas

Lease Name Taylor Well No. #1

Office Address 425 First National Bank Bldg.

Character of Well (completed as Oil, Gas or Dry Hole)

Date well completed 19 69

Application for plugging filed December 19 69

Application for plugging approved December 19 69


Plugging commenced January 5 19 70

Plugging completed January 22 19 70

Reason for abandonment of well or producing formation

If a producing well is abandoned, date of last production 19

Was permission obtained from the Conservation Division or its agents before plugging was commenced? Yes

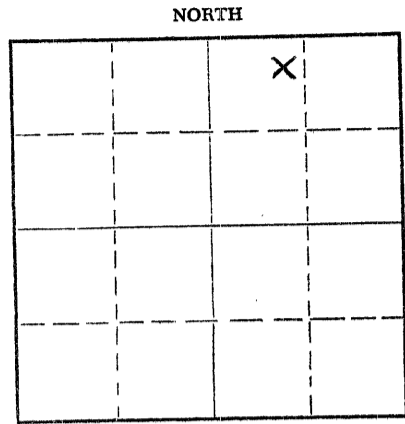

Locate well correctly on above Section Plat

Name of Conservation Agent who supervised plugging of this well Leo Massey

Producing formation Depth to top Bottom Total Depth of Well Feet

Show depth and thickness of all water, oil and gas formations.

OIL, GAS OR WATER RECORDS

CASING RECORD

FORMATION	CONTENT	FROM	TO	SIZE	PUT IN	PULLED OUT
				8 5/8	190	None
				4 1/2	3433	2034

Describe in detail the manner in which the well was plugged, indicating where the mud fluid was placed and the method or methods used in introducing it into the hole. If cement or other plugs were used, state the character of same and depth placed, from feet to feet for each plug set.

January 5, 1970 Plugged off bottom. Dumped sand to 3100'. Mixed and dumped 4 sx of cement to 3050'.


January 22, 1970 Sun Oil Well Cementing Co. mixed and pumped down 8 5/8" casing:
#1 5 sx hulls
#2 14 sx gel
#3 70 sx cement
#4 6 sx gel
#5 50 sx cement

RECEIVED
STATE CORPORATION COMMISSION
MAY 8 1970
CONSERVATION DIVISION
Wichita, Kansas
FEB 6 1970

(If additional description is necessary, use BACK of this sheet)
Name of Plugging Contractor RUSS CASING PULLING, INC. 5-8-70
Address P. O. BOX 1082 GREAT BEND, KANSAS 67530

STATE OF Kansas, COUNTY OF Barton
Russell Sullivan Plugging Contractor of the above-described well, being first duly sworn on oath, says: That I have knowledge of the facts, statements, and matters herein contained and the log of the above-described well as filed and that the same are true and correct. So help me God.

(Signature) Russell Sullivan
(Address)

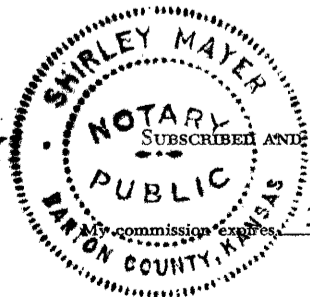

Subscribed and sworn to before me this 5th day of May, 1970
Shirley Mayer Notary Public.