


STATE OF KANSAS  
STATE CORPORATION COMMISSION

Give All Information Completely  
Make Required Affidavit  
Mail or Deliver Report to:  
Conservation Division  
State Corporation Commission  
211 No. Broadway  
Wichita, Kansas

WELL PLUGGING RECORD

15-163-00222-00-00

NORTH

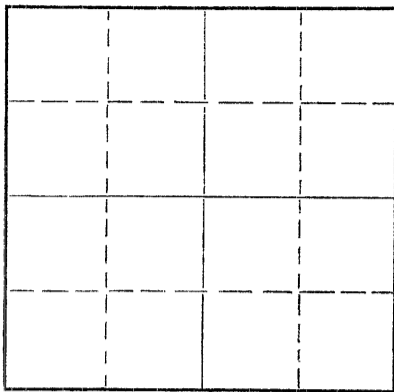

Locate well correctly on above  
Section Plat

ROOKS County. Sec. 28 Twp. 7 Rge. 19 (E) W. (W)  
Location as "NE/CNW/SW" or footage from lines NW/4 NW/4 NE/4  
Lease Owner THEODORE GORE  
Lease Name Theodore Gore-Cramm Well No. 1  
Office Address Wichita, Kansas.  
Character of Well (completed as Oil, Gas or Dry Hole) oil  
Date well completed 4-16-49 19\_\_\_\_  
Application for plugging filed 4-15-57 19\_\_\_\_  
Application for plugging approved 4-16-57 19\_\_\_\_  
Plugging commenced April 19, 1957 19 57  
Plugging completed April 29 19 57  
Reason for abandonment of well or producing formation oil exhausted

If a producing well is abandoned, date of last production \_\_\_\_\_ 19\_\_\_\_  
Was permission obtained from the Conservation Division or its agents before plugging was commenced? yes.

Name of Conservation Agent who supervised plugging of this well Eldon Petty  
Producing formation \_\_\_\_\_ Depth to top \_\_\_\_\_ Bottom \_\_\_\_\_ Total Depth of Well 3472 Feet  
Show depth and thickness of all water, oil and gas formations.

OIL, GAS OR WATER RECORDS

CASING RECORD

FORMATION	CONTENT	FROM	TO	SIZE	PUT IN	PULLED OUT
				8 5/8	183	none
				5 1/2	3424	2337

Describe in detail the manner in which the well was plugged, indicating where the mud fluid was placed and the method or methods used in introducing it into the hole. If cement or other plugs were used, state the character of same and depth placed, from 3472 feet to surface feet for each plug set.

Hole had been plugged back to 3366; Hole filled with sand from 3366 to 3316; four sacks of cement placed in hole with dump bailer, and pipe pulled from hole; thereafter Halliburton pump trucks pumped down and "Squeezed" thirty sacks of mud, followed by plug pumped down with one hundred sacks of cement through eight and five eights inch surface pipe. Plugging Complete.

(If additional description is necessary, use BACK of this sheet)

Name of Plugging Contractor Barnes and Sons Pipe Pulling Co.,  
Address Russell, Kansas.

STATE OF Kansas, COUNTY OF Sedgwick, ss.  
Theodore Gore (employee of owner) or (owner or operator) of the above-described

well, being first duly sworn on oath, says: That I have knowledge of the facts, statements, and matters herein contained and the log of the above-described well as filed and that the same are true and correct. So help me God.

(Signature) Theodore Gore  
400 Brown Bldg., Wichita, Kansas  
(Address)

SUBSCRIBED AND SWORN TO before me this 7th day of May, 1957

My commission expires June 7, 1960

Charlotte Stanley  
Notary Public.

PLUGGING  
FILE SEC. 28 T. 7 R. 19W  
BOOK PAGE 6 LINE 9

RECEIVED  
MAY 8 - 1957  
CONSERVATION DIVISION  
Wichita, Kansas  
5-8-57

WELL LOG BUREAU — KANSAS GEOLOGICAL SOCIETY  
 412 Union National Bk. Bldg., Wichita, Kansas

15-163-00222-00-00


Company - HARRY GORE  
 Farm - Cramm

No. 1

SEC. 28 T. 7 R. 19W  
 NW NW NE

Total Depth. 3472  
 Comm. 4-1-49 Comp. 4-16-49  
 Shot or Treated.  
 Contractor.  
 Issued. 7-16-49

County. Rooks  
 KANSAS

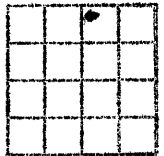

CASING:  
 8 5/8" 183' cem w/135 sx.  
 5 1/2" 3424' cem w/200 sx.

Elevation. 1976  
 1979 KB  
 Production. 66 bbls.

(DSS  
 6-3-65)

Figures indicate Bottom of Formations.

surface clay	50
sand, shale	110
shale, shells	770
sand	890
shale	955
sand	1170
shale	1195
sand	1465
anhydrite	1510
shale, shells	1790
shale, lime	2993
lime	3400
lime, arbuckle	3425
lime	3472
Total Depth	

Tops:  
 Arbuckle 3417 Rig Floor

**PLUGGING**  
 FILE SEC. 28 T. 7 R. 19W  
 BOOK PAGE 6 LINE 9

RECEIVED  
 GEOLOGICAL DIVISION  
 5-8-57