

STATE OF KANSAS
STATE CORPORATION COMMISSION

WELL PLUGGING RECORD

Give All Information Completely
Make Required Affidavit
Mail or Deliver Report to
Conservation Division
State Corporation Comm.
245 North Water
Wichita, KS 67202

Graham County. Sec. 25 Twp. 7S Rge. 22 E/W
Location as "NE/CNW $\frac{1}{4}$ SW $\frac{1}{4}$ " or footage from lines
200' W of NE NW SE


Lease Owner Miles Petroleum & John Roy Evans
Lease Name Legere Well No. 1
Office Address 405 4th, Claflin, KS 67525
Character of Well (Completed as Oil, Gas or Dry Hole) Dry Hole

Date Well completed 12-29 1978
Application for plugging filed 12-29 1978
Application for plugging approved 12-29 1978
Plugging commenced 12-29 1978
Plugging completed 12-29 1978
Reason for abandonment of well or producing formation Dry Hole

If a producing well is abandoned, date of last production 19__

Was permission obtained from the Conservation Division or its agents before plugging was commenced? Yes

Name of Conservation Agent who supervised plugging of this well Gil Bathalzor
Producing formation _____ Depth to top _____ Bottom _____ Total Depth of Well 3770
Show depth and thickness of all water, oil and gas formations.

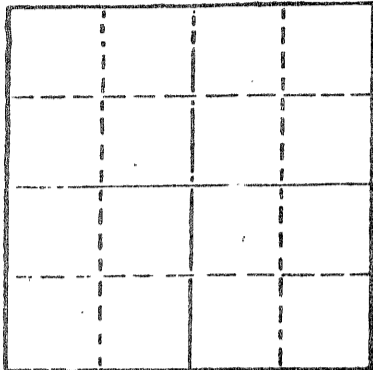

Locate well correctly on above Section Plat

OIL, GAS OR WATER RECORDS

CASING RECORD

FORMATION	CONTENT	FROM	TO	SIZE	PUT IN	PULLED OUT
				8-5/8"	217	-0-

Describe in detail the manner in which the well was plugged, indicating where the mud fluid was placed and the method or methods used in introducing it into the hold. If cement or other plugs were used, state the character of same and depth placed, from _____ feet to _____ feet for each plug set.

Mud laden fluid 3770 - 800
70 sks cement @ 800'
20 sks cement @ 215'
10 sks cement @ 40'
2 sks cement in rat hole

(If additional description is necessary, use BACK of this sheet)

Name of Plugging Contractor Emphasis Oil Operations

1-9-79

STATE OF KANSAS COUNTY OF RUSSELL, ss.
Joe K. Branum (employee of owner) or (owner or operator)
of the above-described well, being first duly sworn on oath, says: That I have knowledge of the facts, statements, and matters herein contained and the log of the above-described well as filed and that the same are true and correct. So help me God.

(Signature)

Joe K. Branum
Box 506, Russell, KS 67665

(Address)

SUBSCRIBED AND SWORN TO before me this 4th day of January, 19 79

Patricia J. Clark
Notary Public.

My commission expires October 2, 1979

