


15-065-19041-06-00

Give All Information Completely
Make Required Affidavit
Mail or Deliver Report to:
Conservation Division
State Corporation Commission
800 Bitting Building
Wichita, Kansas

WELL PLUGGING RECORD

NORTH

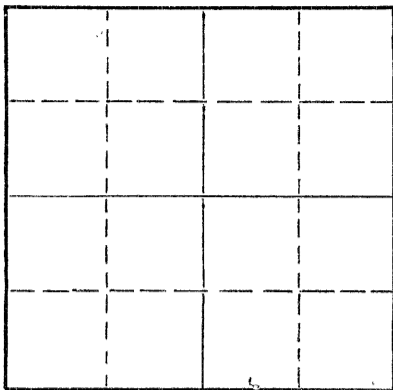

Locate well correctly on above
Section Plat

Graham

County. Sec. 23 Twp 7 Rge. 22 (E) W (W)

Location as "NE/CNW/SW" or footage from lines NW/4 NW/4 NW/4

Lease Owner V.D. Sidey Oil Co.,

Lease Name Sidey Oil Co - Worcester Well No. 1

Office Address Russell, Kansas.

Character of Well (completed as Oil, Gas or Dry Hole)

Date well completed 19

Application for plugging filed 19

Application for plugging approved 19

Plugging commenced March 18 19 55

Plugging completed March 30 19 55

Reason for abandonment of well or producing formation

If a producing well is abandoned, date of last production 19

Was permission obtained from the Conservation Division or its agents before plugging was commenced? yes.

Name of Conservation Agent who supervised plugging of this well Eldon Petty

Producing formation Depth to top Bottom Total Depth of Well 3819 Feet

Show depth and thickness of all water, oil and gas formations.

OIL, GAS OR WATER RECORDS

CASING RECORD

FORMATION	CONTENT	FROM	TO	SIZE	PUT IN	PULLED OUT

Describe in detail the manner in which the well was plugged, indicating where the mud fluid was placed and the method or methods used in introducing it into the hole. If cement or other plugs were used, state the character of same and depth placed, from 3819 feet to Surface feet for each plug set.

Hole filled with sand from 3819 to 3780 ft; Cement plug placed with dump bailer from 3780 to 3756; sand placed in hole from 3756 to 3640; cement plug placed with dump bailer 3640 to 3616; Hole filled with mud from 3616 to 200 feet; ten foot rock bridge installed between 200 and 190; Fifteen sacks of cement poured in hole and hole filled with mud to 35 ft; five foot rock bridge installed between 35 feet and 30 feet and hole capped with 10 sacks of cement

Plugging Complete.

RECEIVED
STATE CORPORATION COMMISSION
APR 21 1955
CONSERVATION DIVISION
Wichita, Kansas

4-21-55

(If additional description is necessary, use BACK of this sheet)

Name of Plugging Contractor Barnes and Sons Pipe Pulling Co., Russell, Kansas.
Address

STATE OF Kansas, COUNTY OF Russell, ss.

(employee of owner) or (owner or operator) of the above-described well, being first duly sworn on oath, says: That I have knowledge of the facts, statements, and matters herein contained and the log of the above-described well as filed and that the same are true and correct. So help me God.

(Signature) V.D. Sidey

(Address)

SUBSCRIBED AND SWORN TO before me this 19th day of April, 1955

Marquitta Begone
Notary Public.

My commission expires September 17, 1956

PLUGGING
FILE SEC 23 T 7 R 22W
BOOK PAGE 108 LINE 39