

15-065-03319-00-00

STATE OF KANSAS
STATE CORPORATION COMMISSION

WELL PLUGGING RECORD

Give All Information Completely
Make Required Affidavit
Mail or Deliver Report to:
Conservation Division
State Corporation Commission
800 Bitting Building
Wichita, Kansas

Graham County. Sec. 22 Twp. 68 Rge. 7S (E) 22(W)

Location as "NE/CNW $\frac{1}{4}$ SW $\frac{1}{4}$ " or footage from lines C E/2 NE NE

Lease Owner Jones, Shelburne & Farmer, Inc.

Lease Name Weissback Well No. 1

Office Address Russell, Kansas

Character of Well (completed as Oil, Gas or Dry Hole) Dry

Date well completed 3-6 1952

Application for plugging filed 10-15 1952

Application for plugging approved 10-15 1952


Plugging commenced 10-15 1952

Plugging completed 10-15 1952

Reason for abandonment of well or producing formation Dry

If a producing well is abandoned, date of last production 5-10 1952

Was permission obtained from the Conservation Division or its agents before plugging was commenced? yes

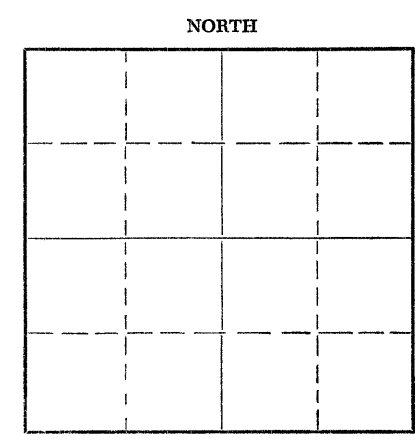

Locate well correctly on above Section Plat

Name of Conservation Agent who supervised plugging of this well Elden Petty

Producing formation Depth to top Bottom Total Depth of Well 3848 Feet

Show depth and thickness of all water, oil and gas formations.

OIL, GAS OR WATER RECORDS

CASING RECORD

FORMATION	CONTENT	FROM	TO	SIZE	PUT IN	PULLED OUT
				8 5/8	165	none
				5 1/2	3840	3000

Describe in detail the manner in which the well was plugged, indicating where the mud fluid was placed and the method or methods used in introducing it into the hole. If cement or other plugs were used, state the character of same and depth placed, from feet to feet for each plug set.

- Hole filled with chat to 3840'
- Four sacks cement dumped with dump baileron chat
- Pipe shot and pulled at 3000
- Hole filled with mud to 165
- Rock bridge set at 165' with 15sacks cement on top
- Mudded to 35'
- Five feet rock bridge set at 35'
- Ten sacks cement mixed and hole filled to top

(If additional description is necessary, use BACK of this sheet)

Name of Plugging Contractor Frank Carroll
Address Great Bend, Kansas

STATE OF _____, COUNTY OF _____, ss.
_____(employee of owner) or (owner or operator) of the above-described well, being first duly sworn on oath, says: That I have knowledge of the facts, statements, and matters herein contained and the log of the above-described well as filed and that the same are true and correct. So help me God.

(Signature) John D. Farmer
(Address) _____

SUBSCRIBED AND SWORN TO before me this 21st day of January, 1953

Bonnie Berryhill
Notary Public.

My commission expires April 23, 1956

